


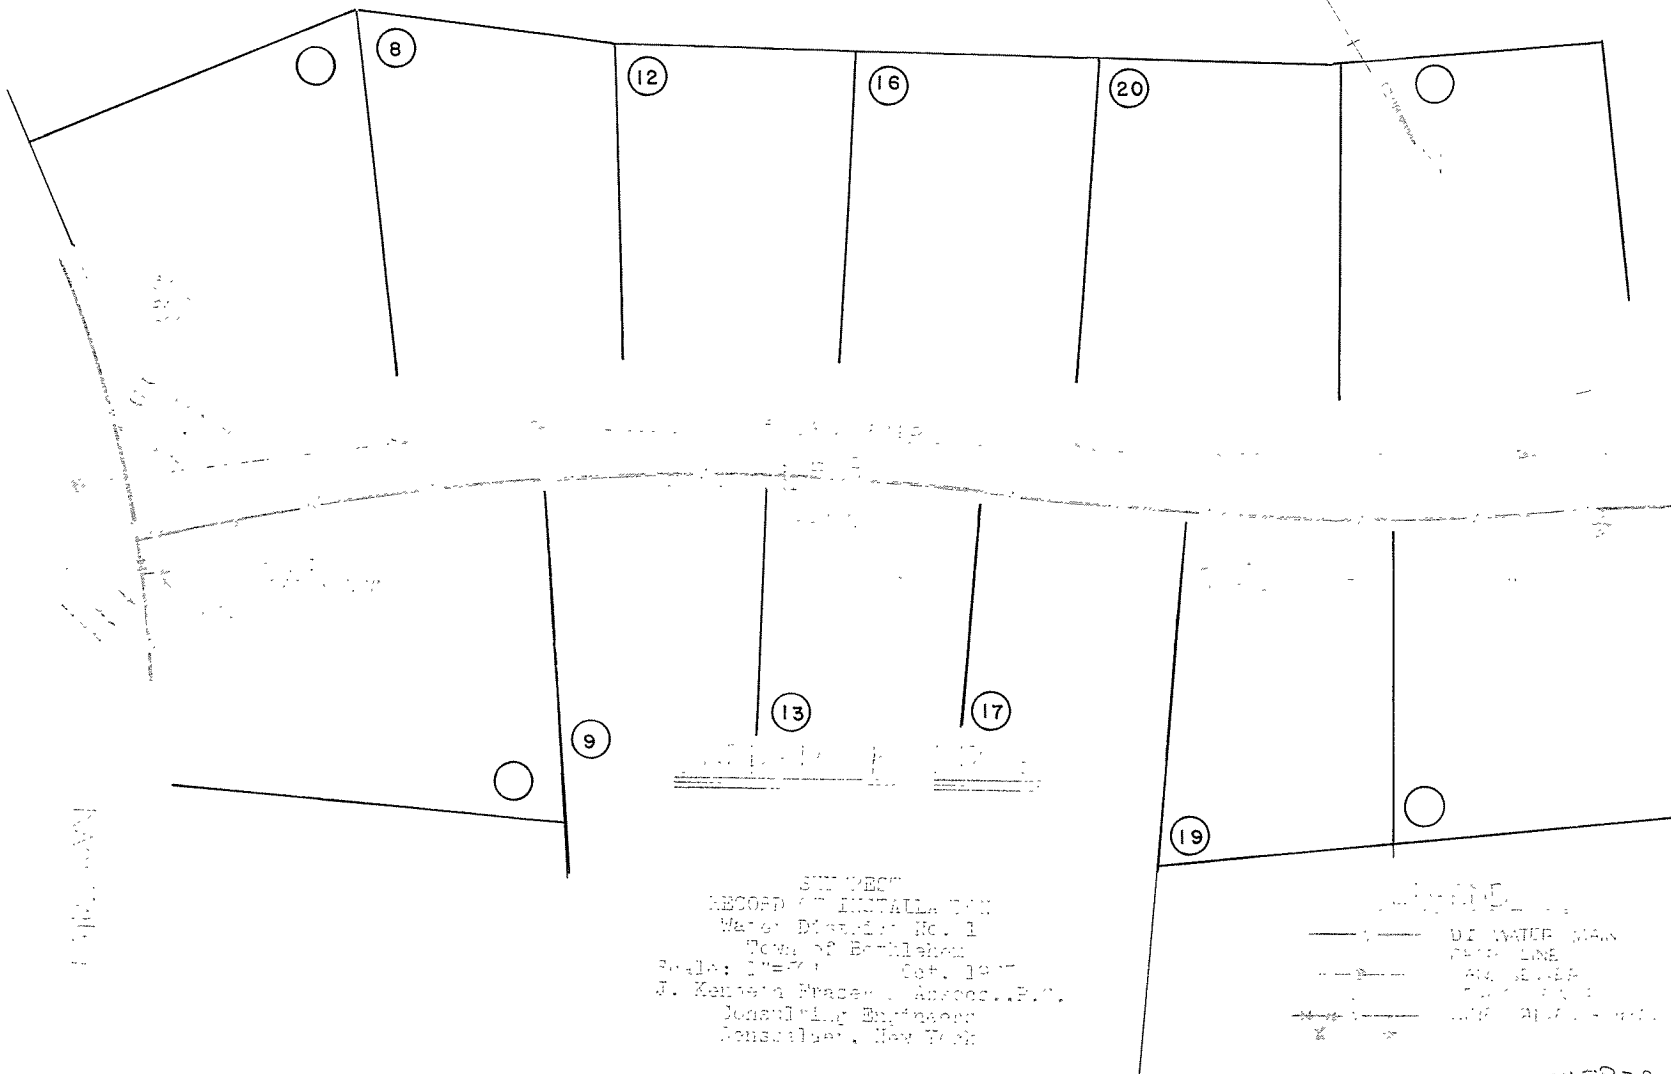

SHEPHERD
 RECORD OF INSTALLATION
 Water District No. 1
 Town of Bethlehem
 Scale: 1"=20' Oct. 1917
 J. Kenneth Fraser, Assoc. P.E.
 Consulting Engineer
 Consultant, New York

OF WATER MAIN
 CENTER LINE
 SIDE LINE
 SIDE LINE
 SIDE LINE

SHERBROOK DRIVE