
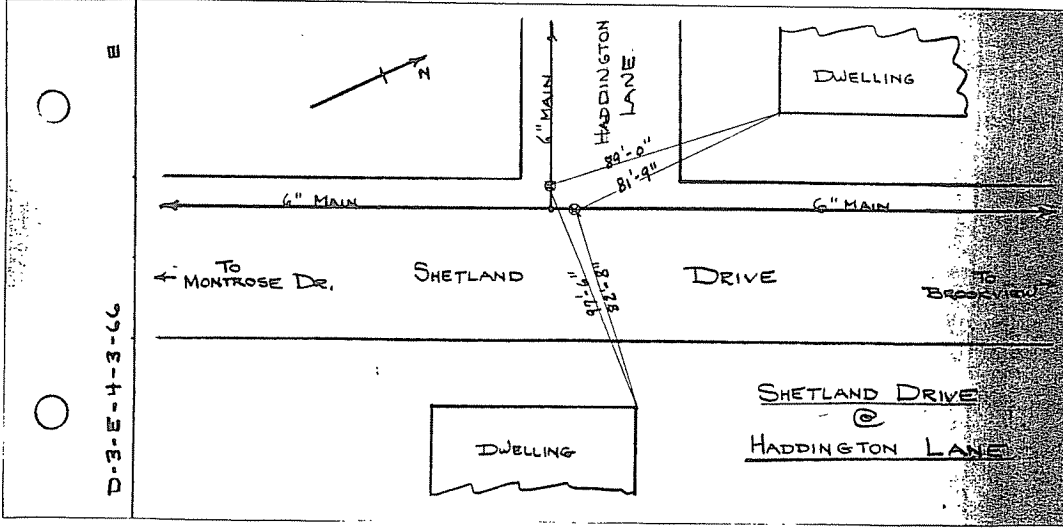


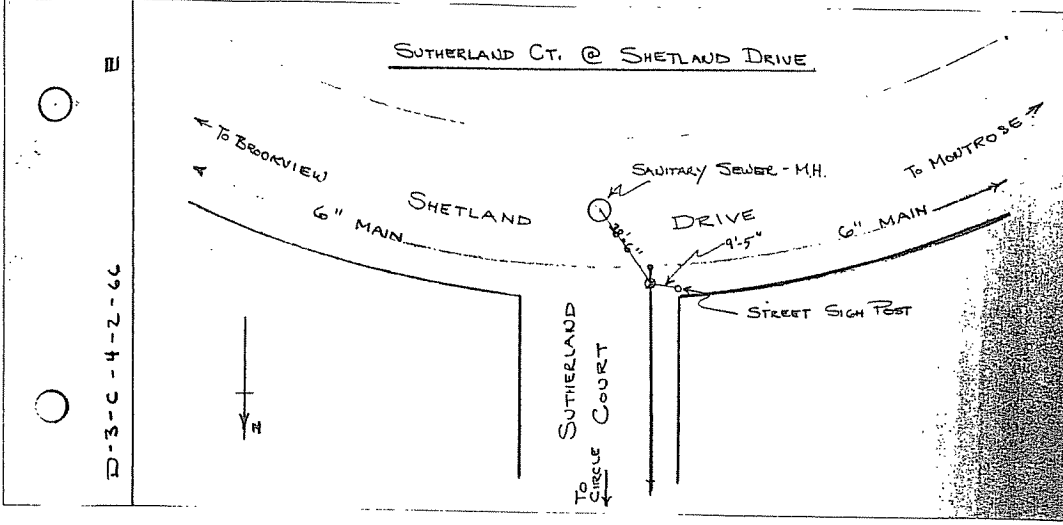

SHETLAND DRIVE
WATER MAIN