

SIBLEY PLACE

WATER DISTRICT NO.1

TOWN OF BETHLEHEM

RECORD OF INSTALLATION


TOWN OF BETHLEHEM ENGINEERING

DEPARTMENT

SCALE: 1" = 100'

JUNE, 1984

DWN. BY: KT

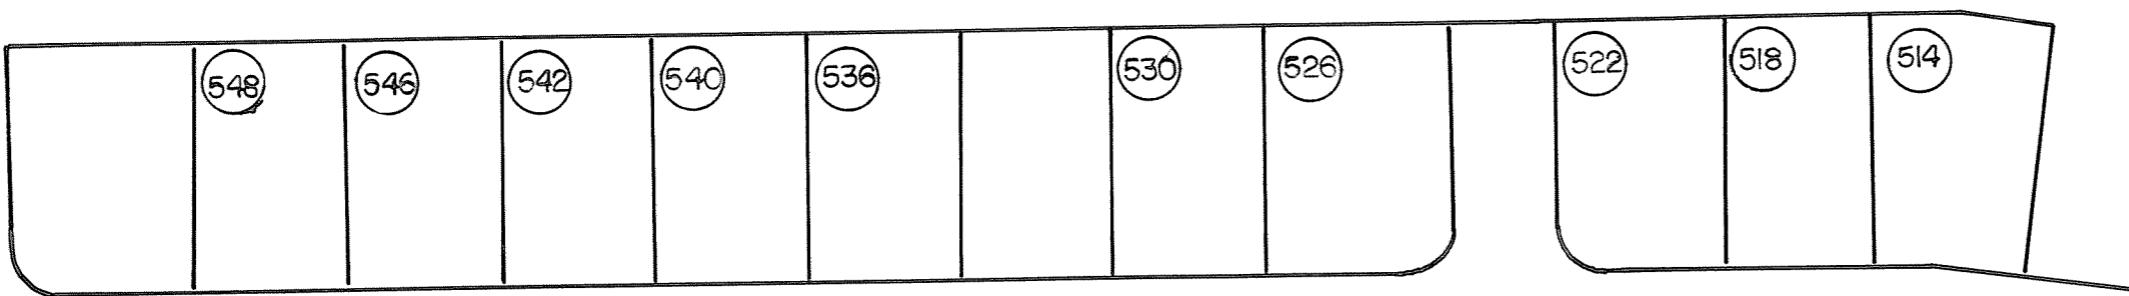

HURON

ROAD

CHERRy

AVENUE

CARSON

SIBLEY
PLACE

ROAD

WAYNE
PLACE

DRIVE

DRIVE

10 45
128 41

539 537 533 531 527
540 536 532 520 526

38 40
39 41

102 67
63
59
114 55
118 51

68 533
64 535
536 63
532 530

ST. CLAIR

64 67
60 65
58 61
54 57
52 53
51 48
46 42

LANSING

47 45
41