


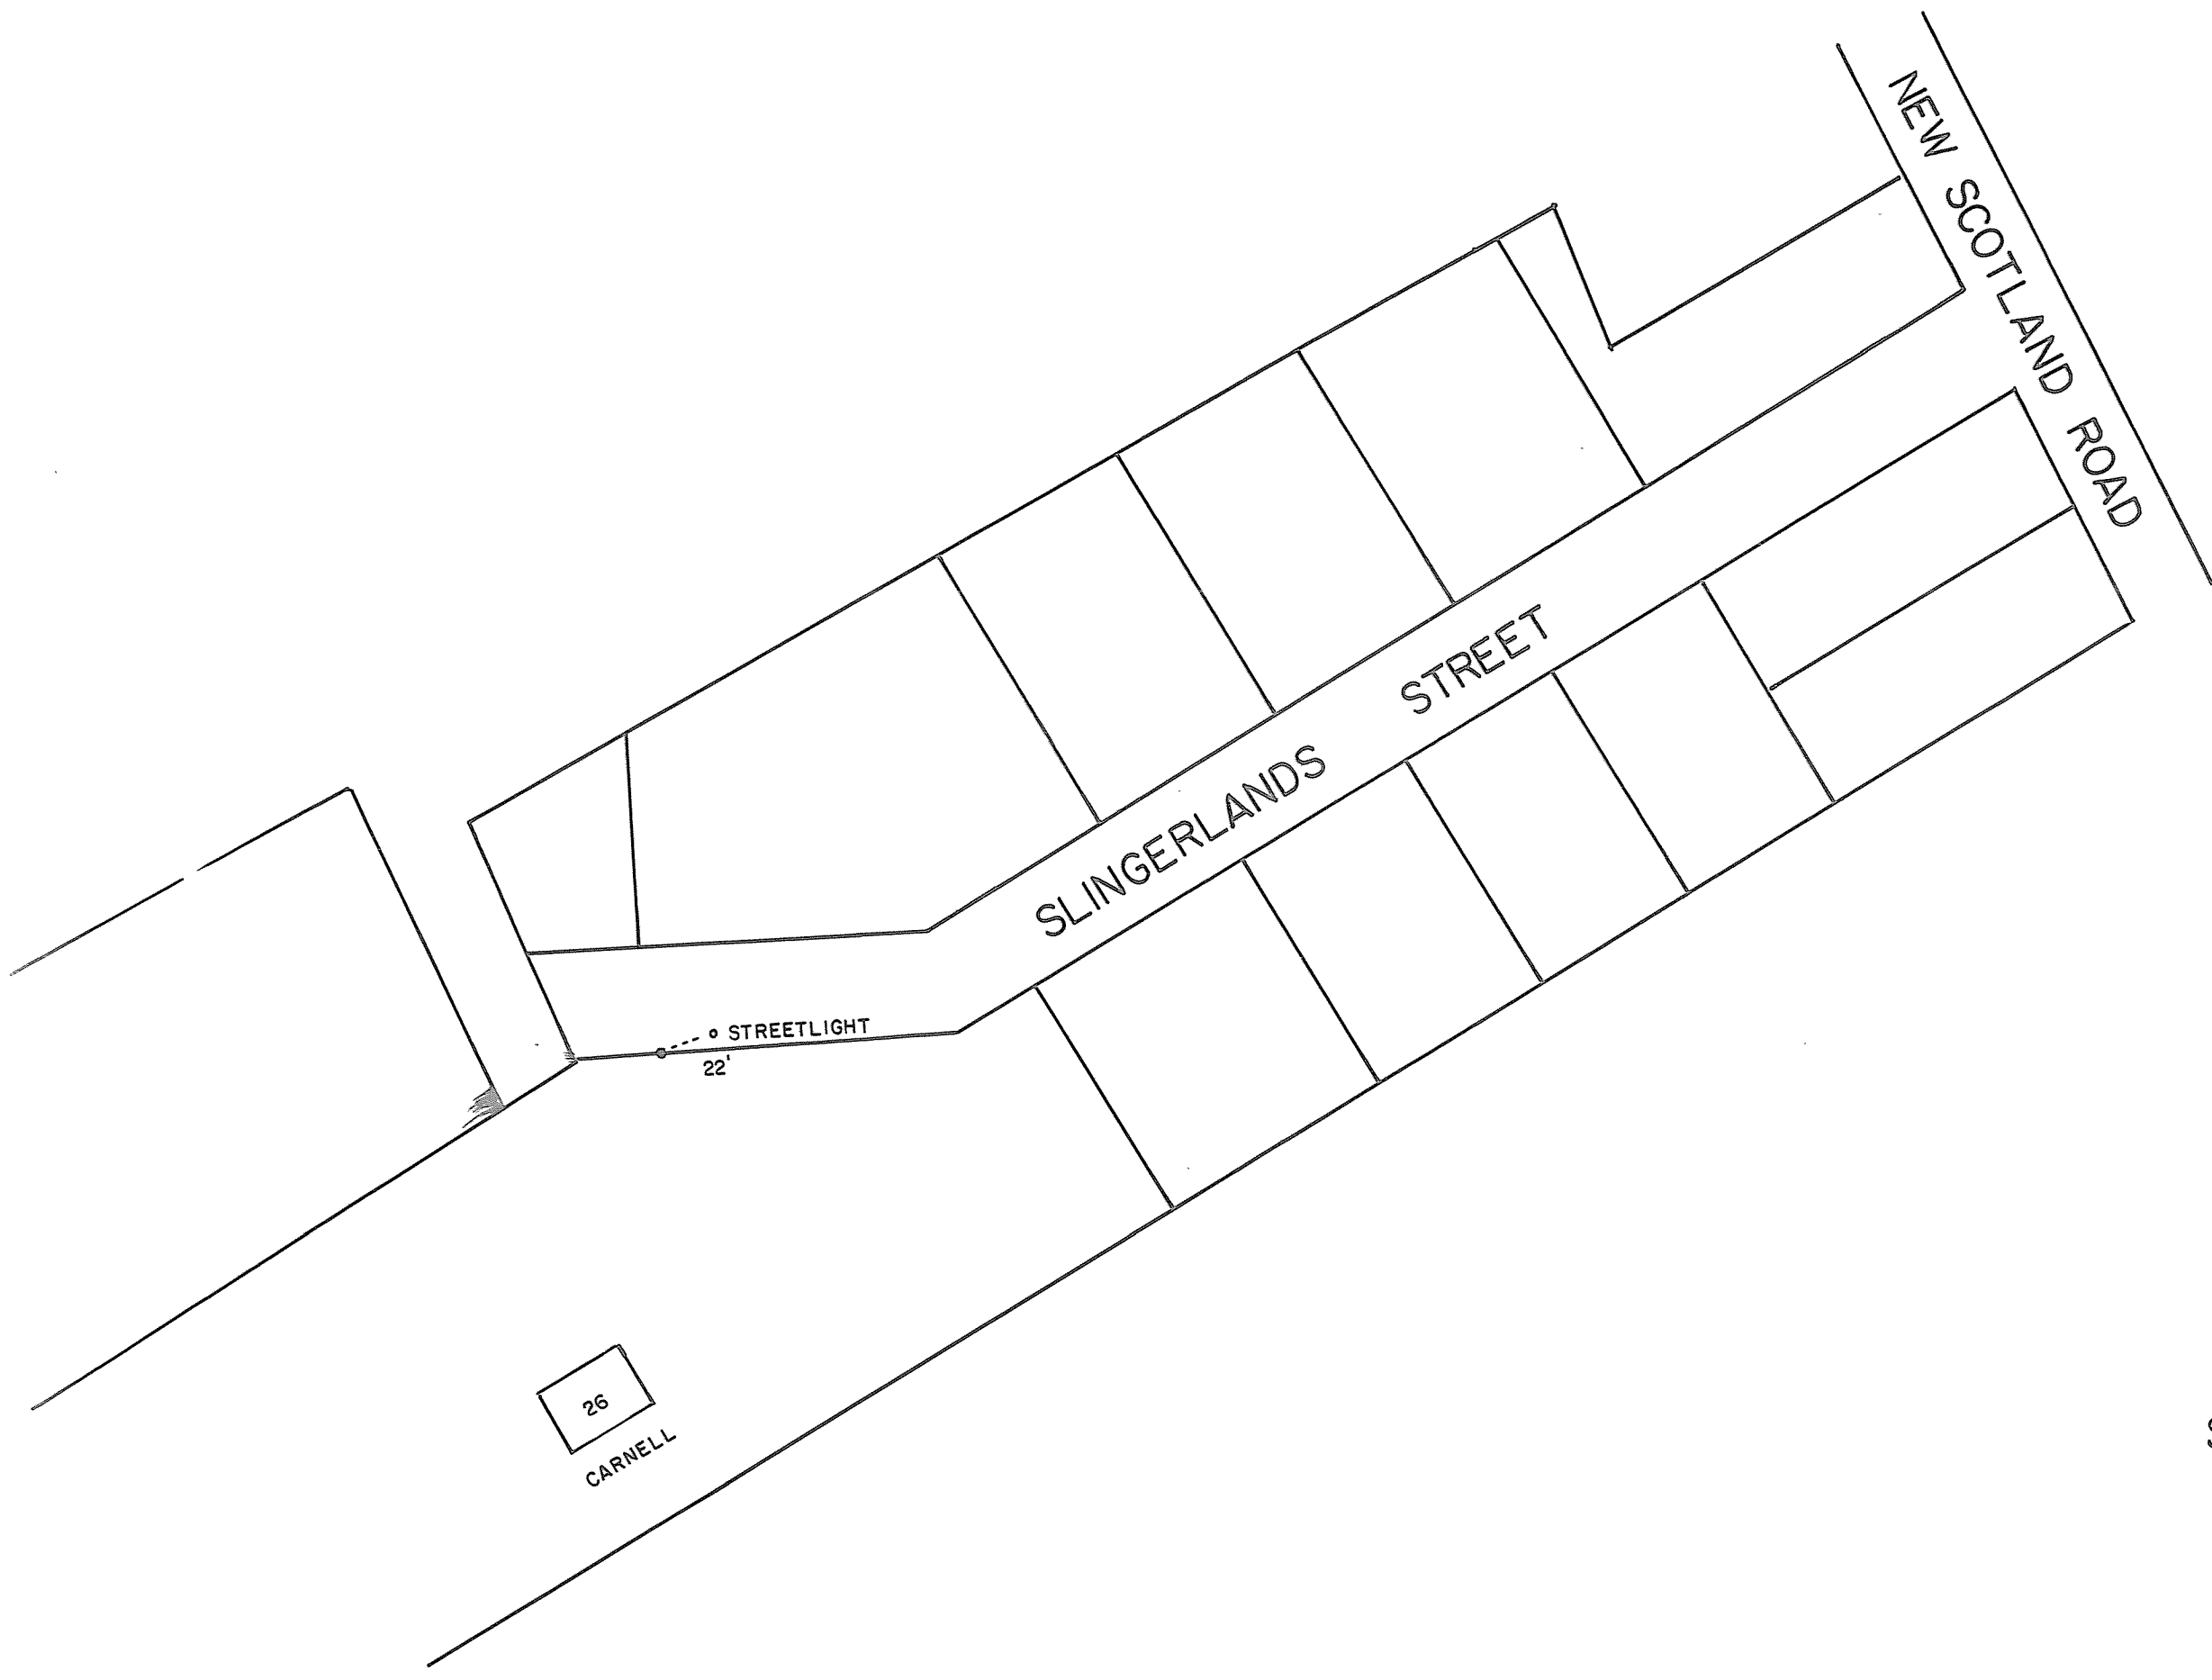

SLINGERLAND STREET