 


LEGEND

- CATCH BASIN
- MANHOLE
- ⊙ HYDRANT
- ⊕ GATE VALVE
- ⊥ TEE
- ▲ TRUSS BLOCK
- W— WATER MAIN
- SA— SANITARY SEWER
- ST--- STORM SEWER



DRAWN BY M.G.  
CHECKED BY D.M.S.

SOMERSET WOODS  
WATER MAIN & CURB BOXES

SEPT. 25, 1990  
SCALE: 1" = 50'

RECORD  
DRAWING