


LEGEND

- CATCH BASIN
- MANHOLE
- ✖ HYDRANT
- GATE VALVE
- TEE
- ▲ THRUST BLOCK
- W— WATER MAIN
- SA— SANITARY SEWER
- ST— STORM SEWER

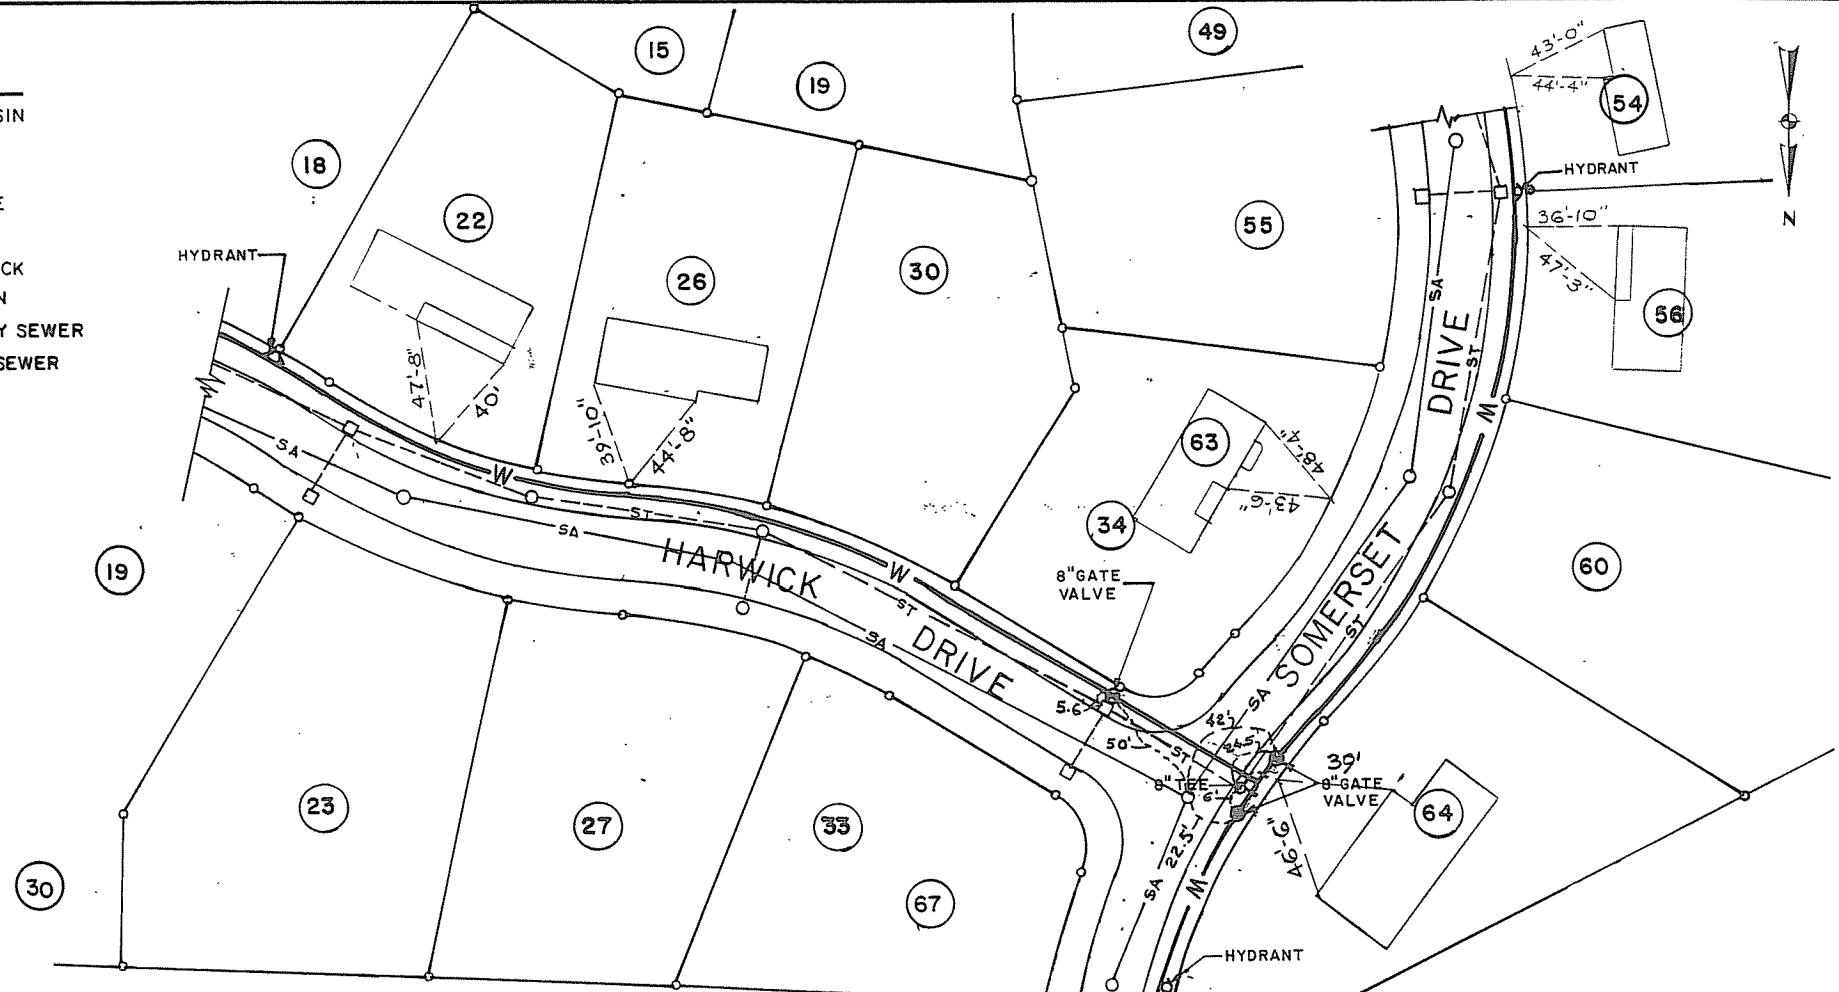

SOMERSET WOODS
WATER MAIN

DRAWN BY MG.
CHECKED BY DMS.

SEPT. 24, 1990
SCALE: 1" = 50'

RECORD
DRAWING