


LEGEND

- CATCH BASIN
- MANHOLE
- HYDRANT
- ⊕ GATE VALVE
- T TEE
- ▲ THRUST BLOCK
- W— WATER MAIN
- SA— SANITARY SEWER
- ST--- STORM SEWER

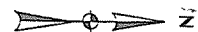

DRAWN BY M.G.  
CHECKED BY DMS.

SOMERSET WOODS

WATER MAIN & CURB BOXES

SEPT. 25, 1990  
SCALE: 1" = 50'

RECORD  
DRAWING