


NEW SCOTLAND ROAD

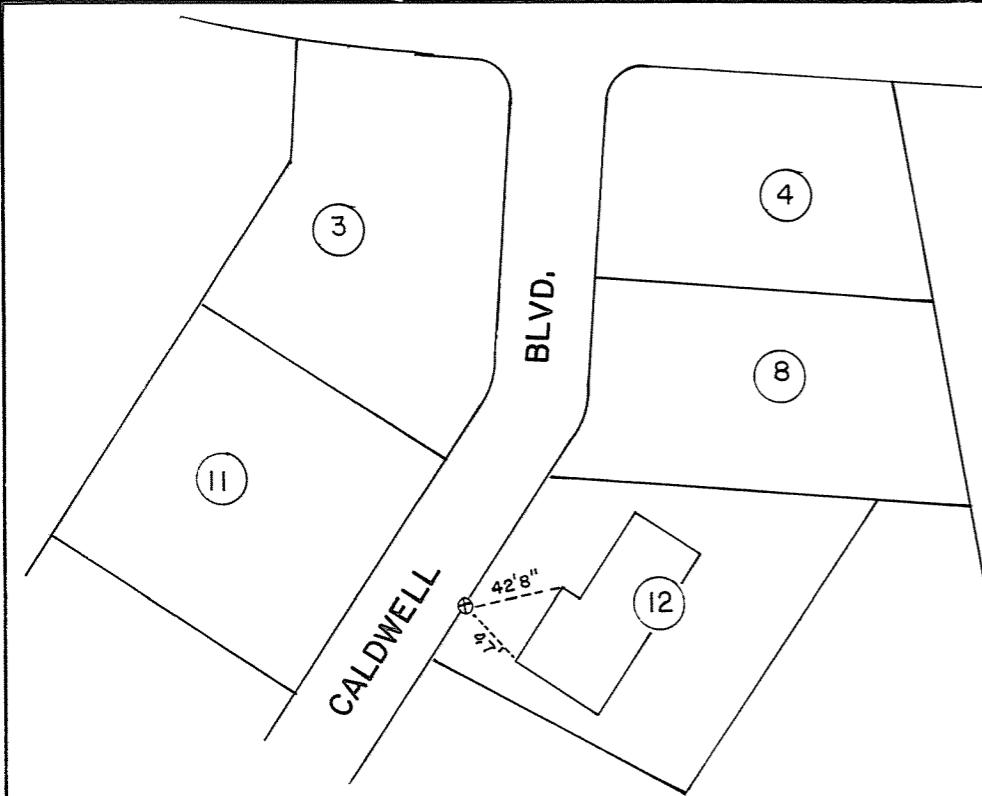

SOUTH HELDERBERG PARKWAY

WATER DISTRICT NO. 1

TOWN OF BETHLEHEM

RECORD OF INSTALLATION

TOWN OF BETHLEHEM ENGINEERING

DEPARTMENT

SCALE 1"=100' DECEMBER, 1981

DWN. BY: PDH

