


TWR

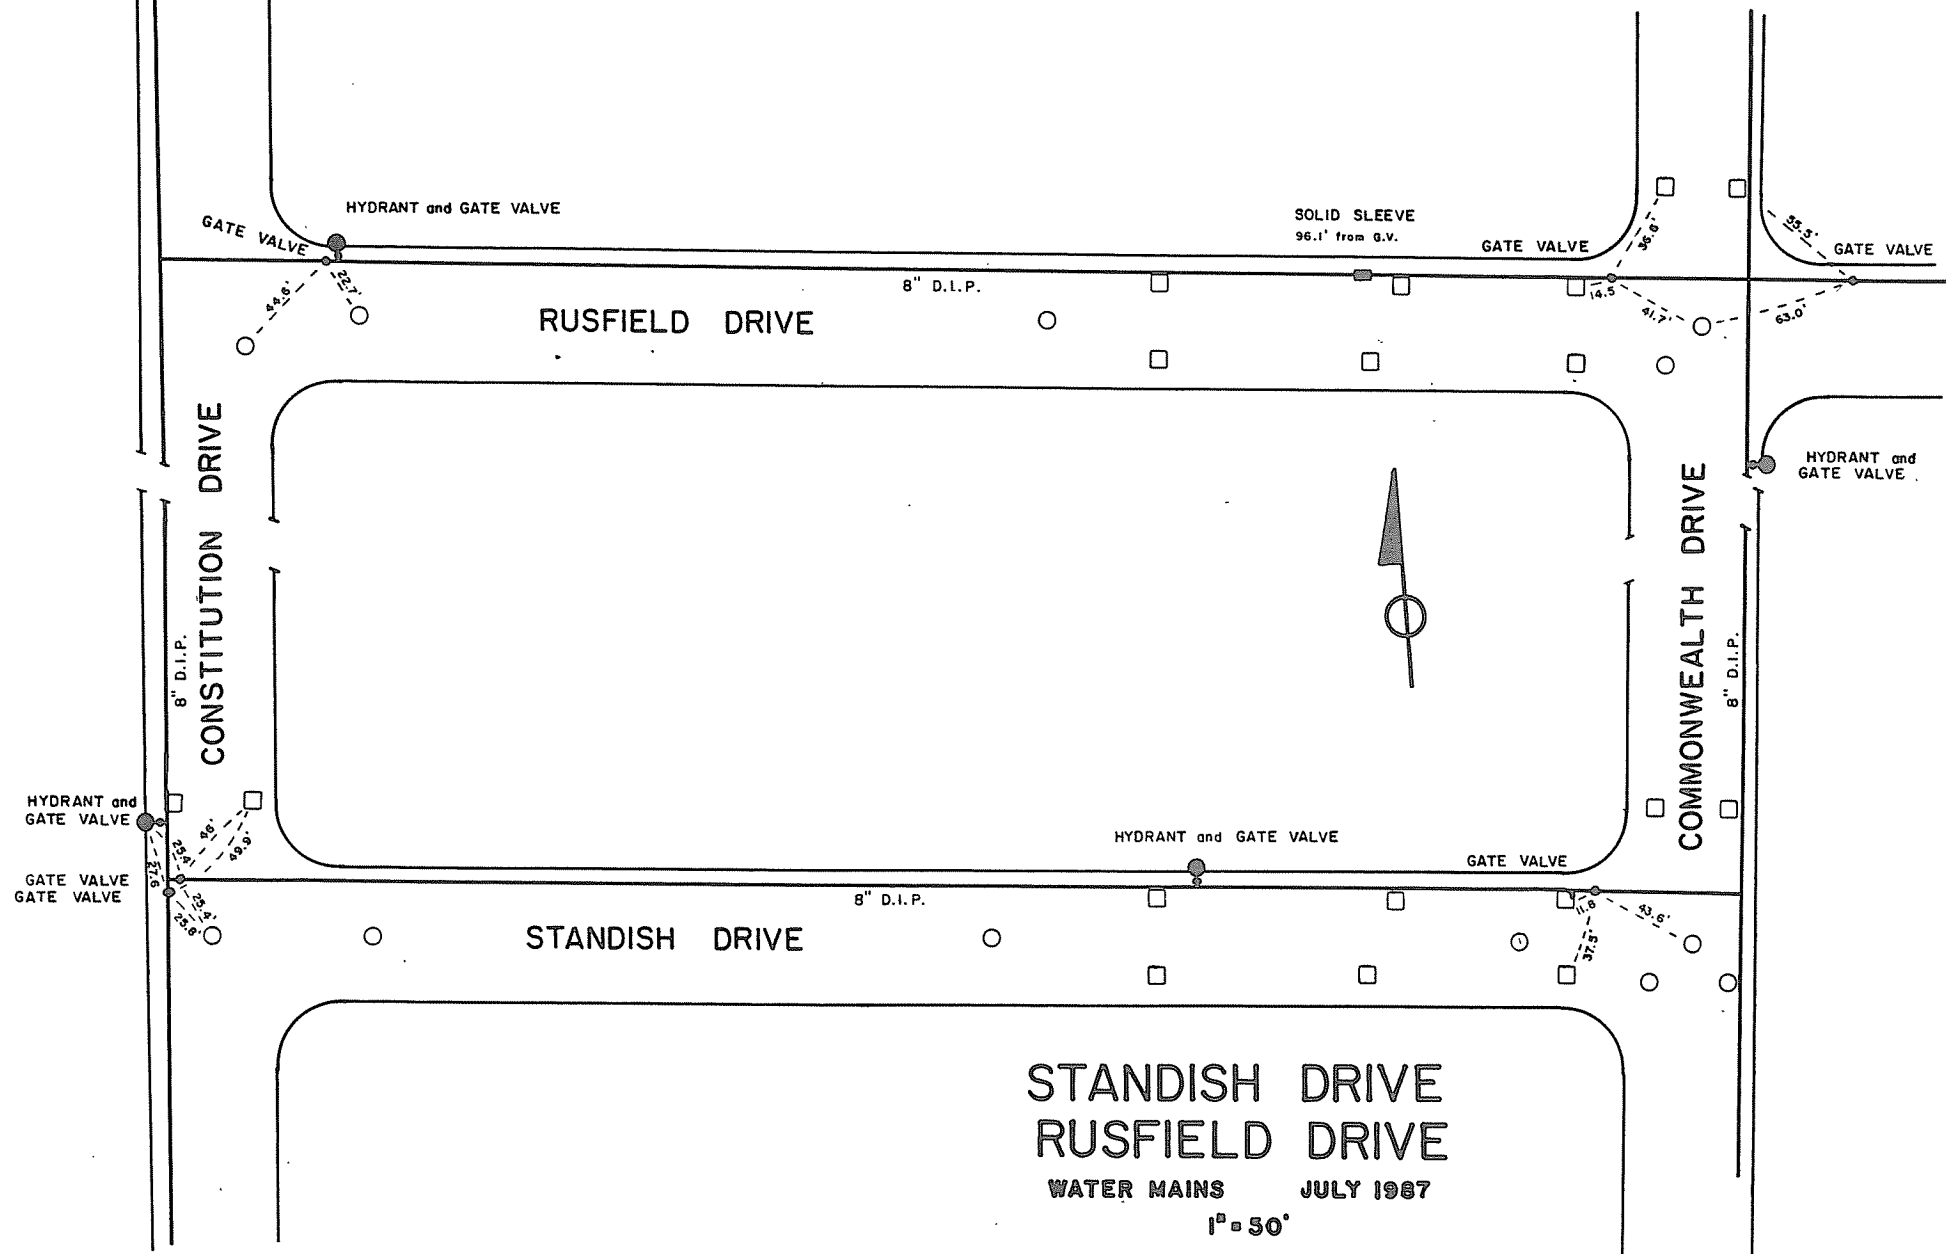

STANDISH DRIVE
RUSFIELD DRIVE
WATER MAINS JULY 1987
1" = 50'