


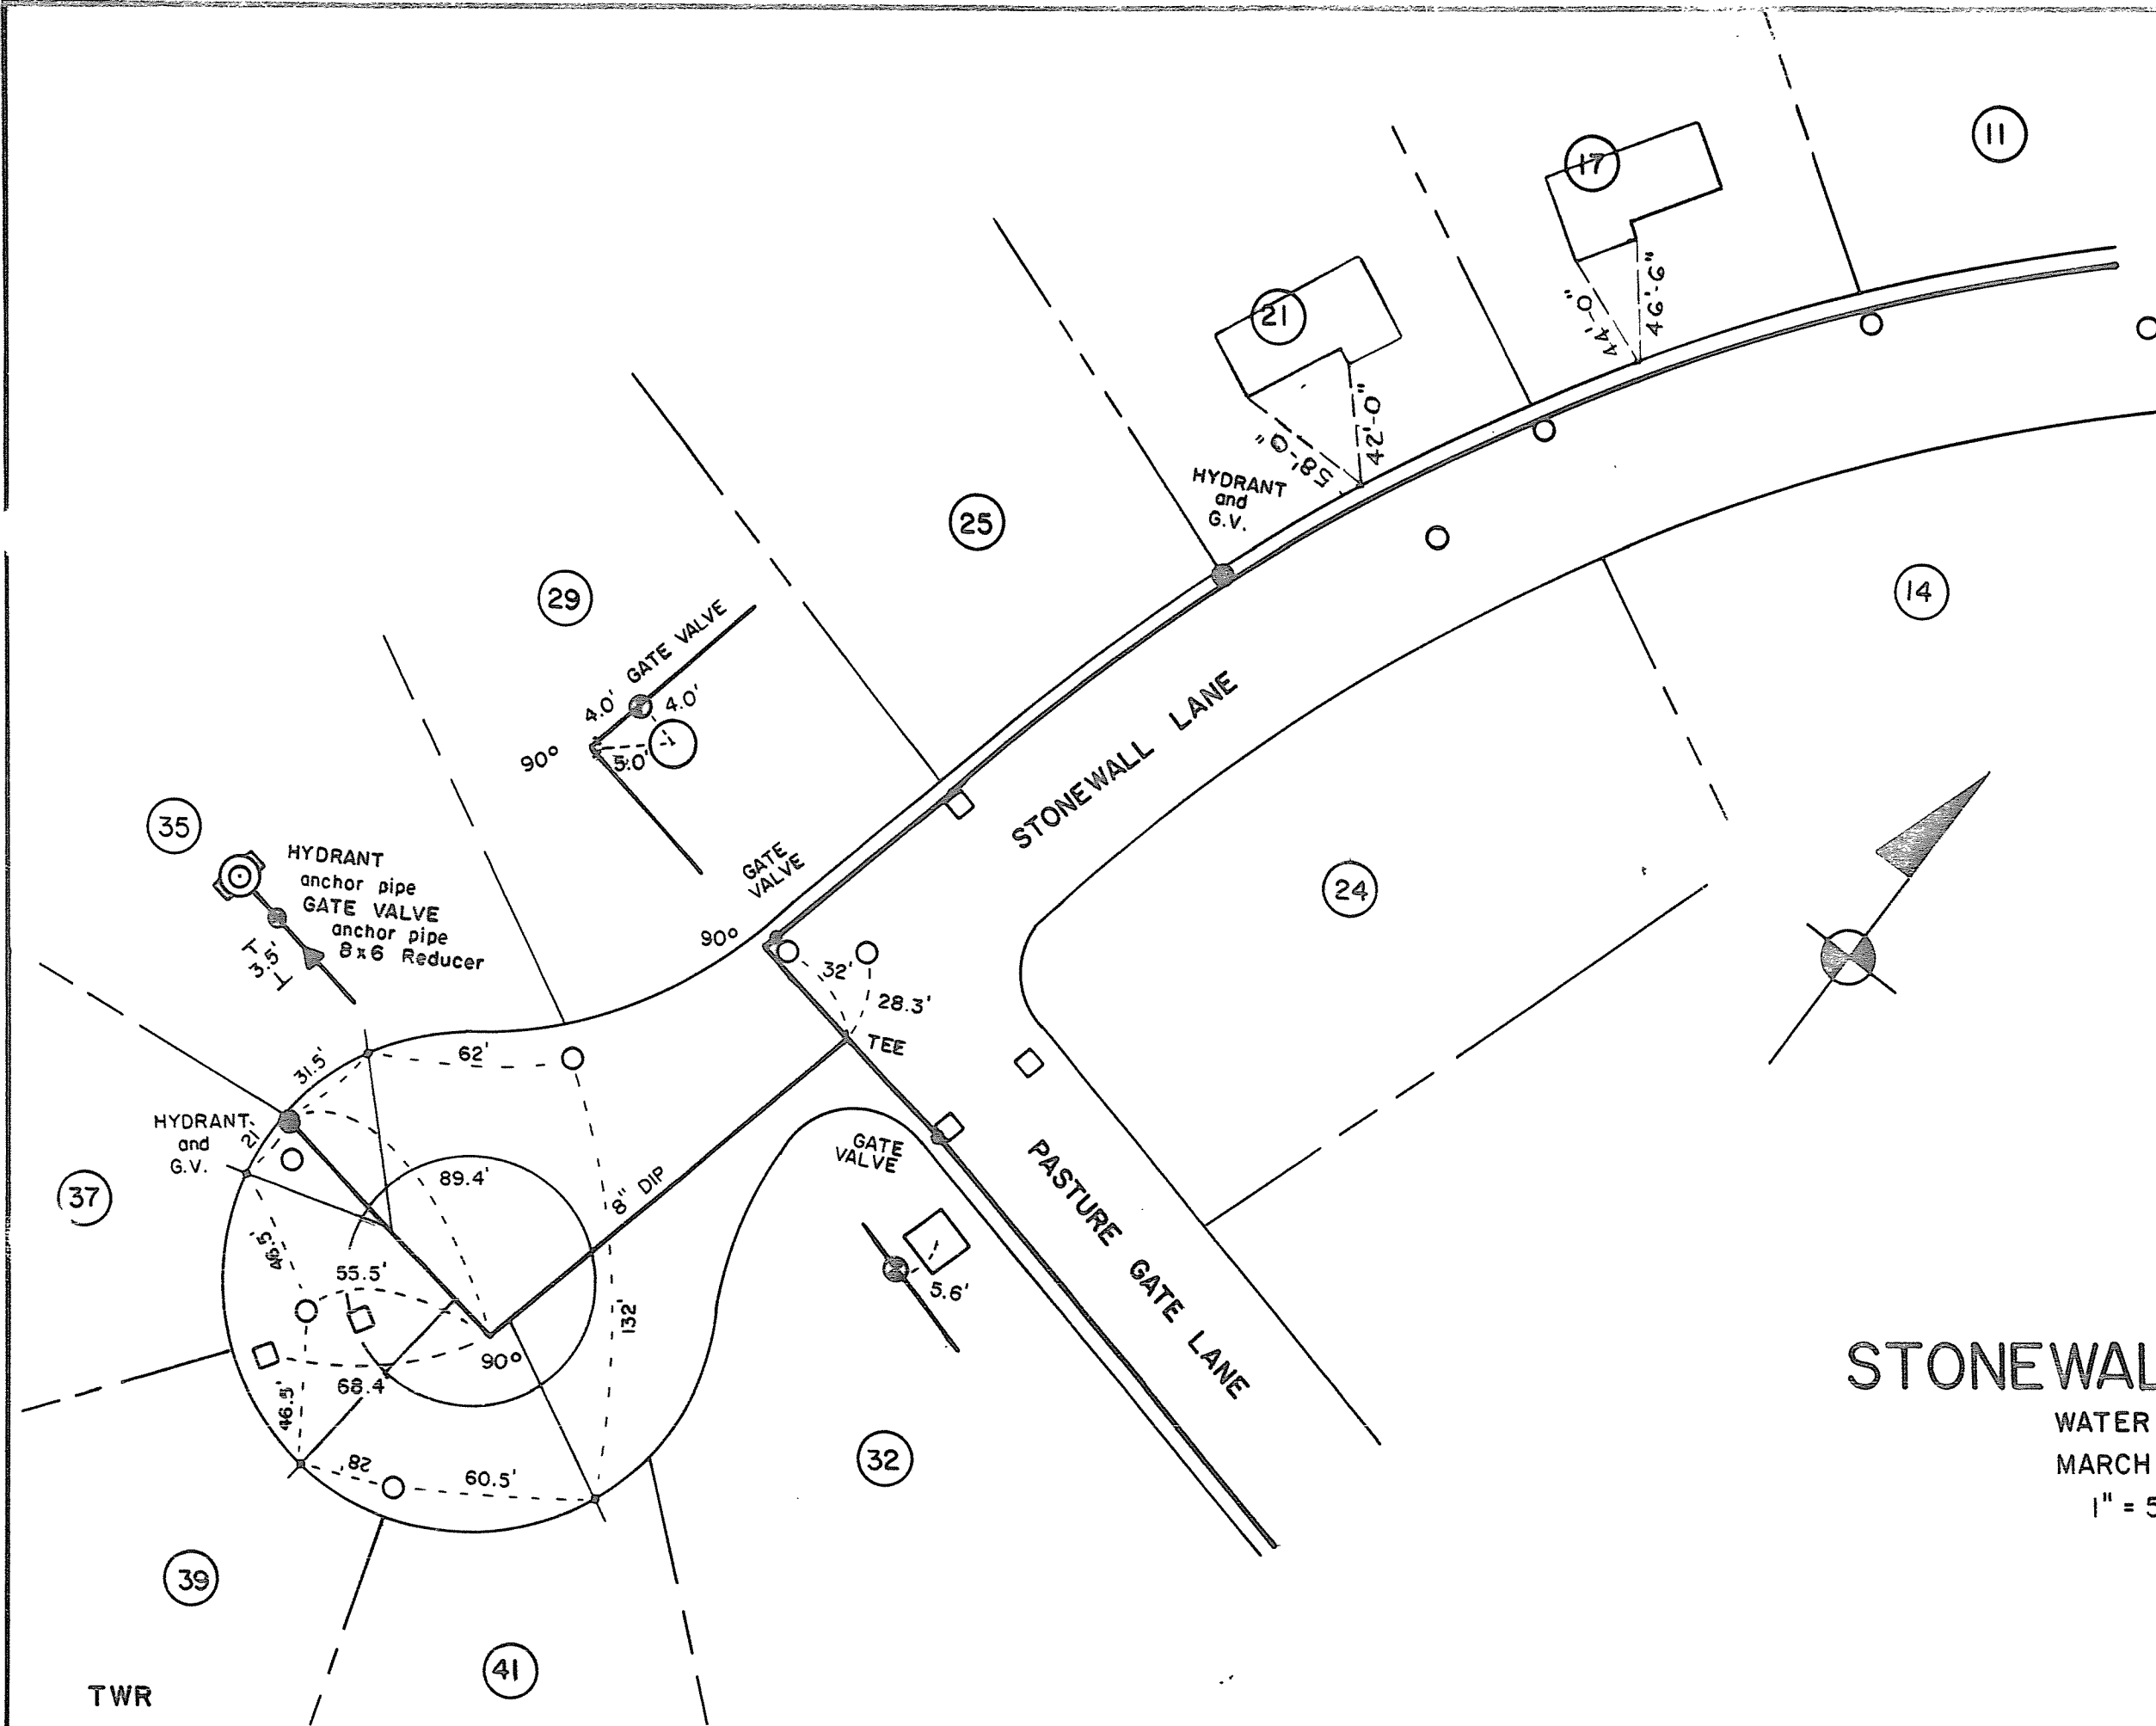

# STONEWALL LANE

WATER MAIN & CURB  
MARCH 1988 BOXES

1" = 50'