


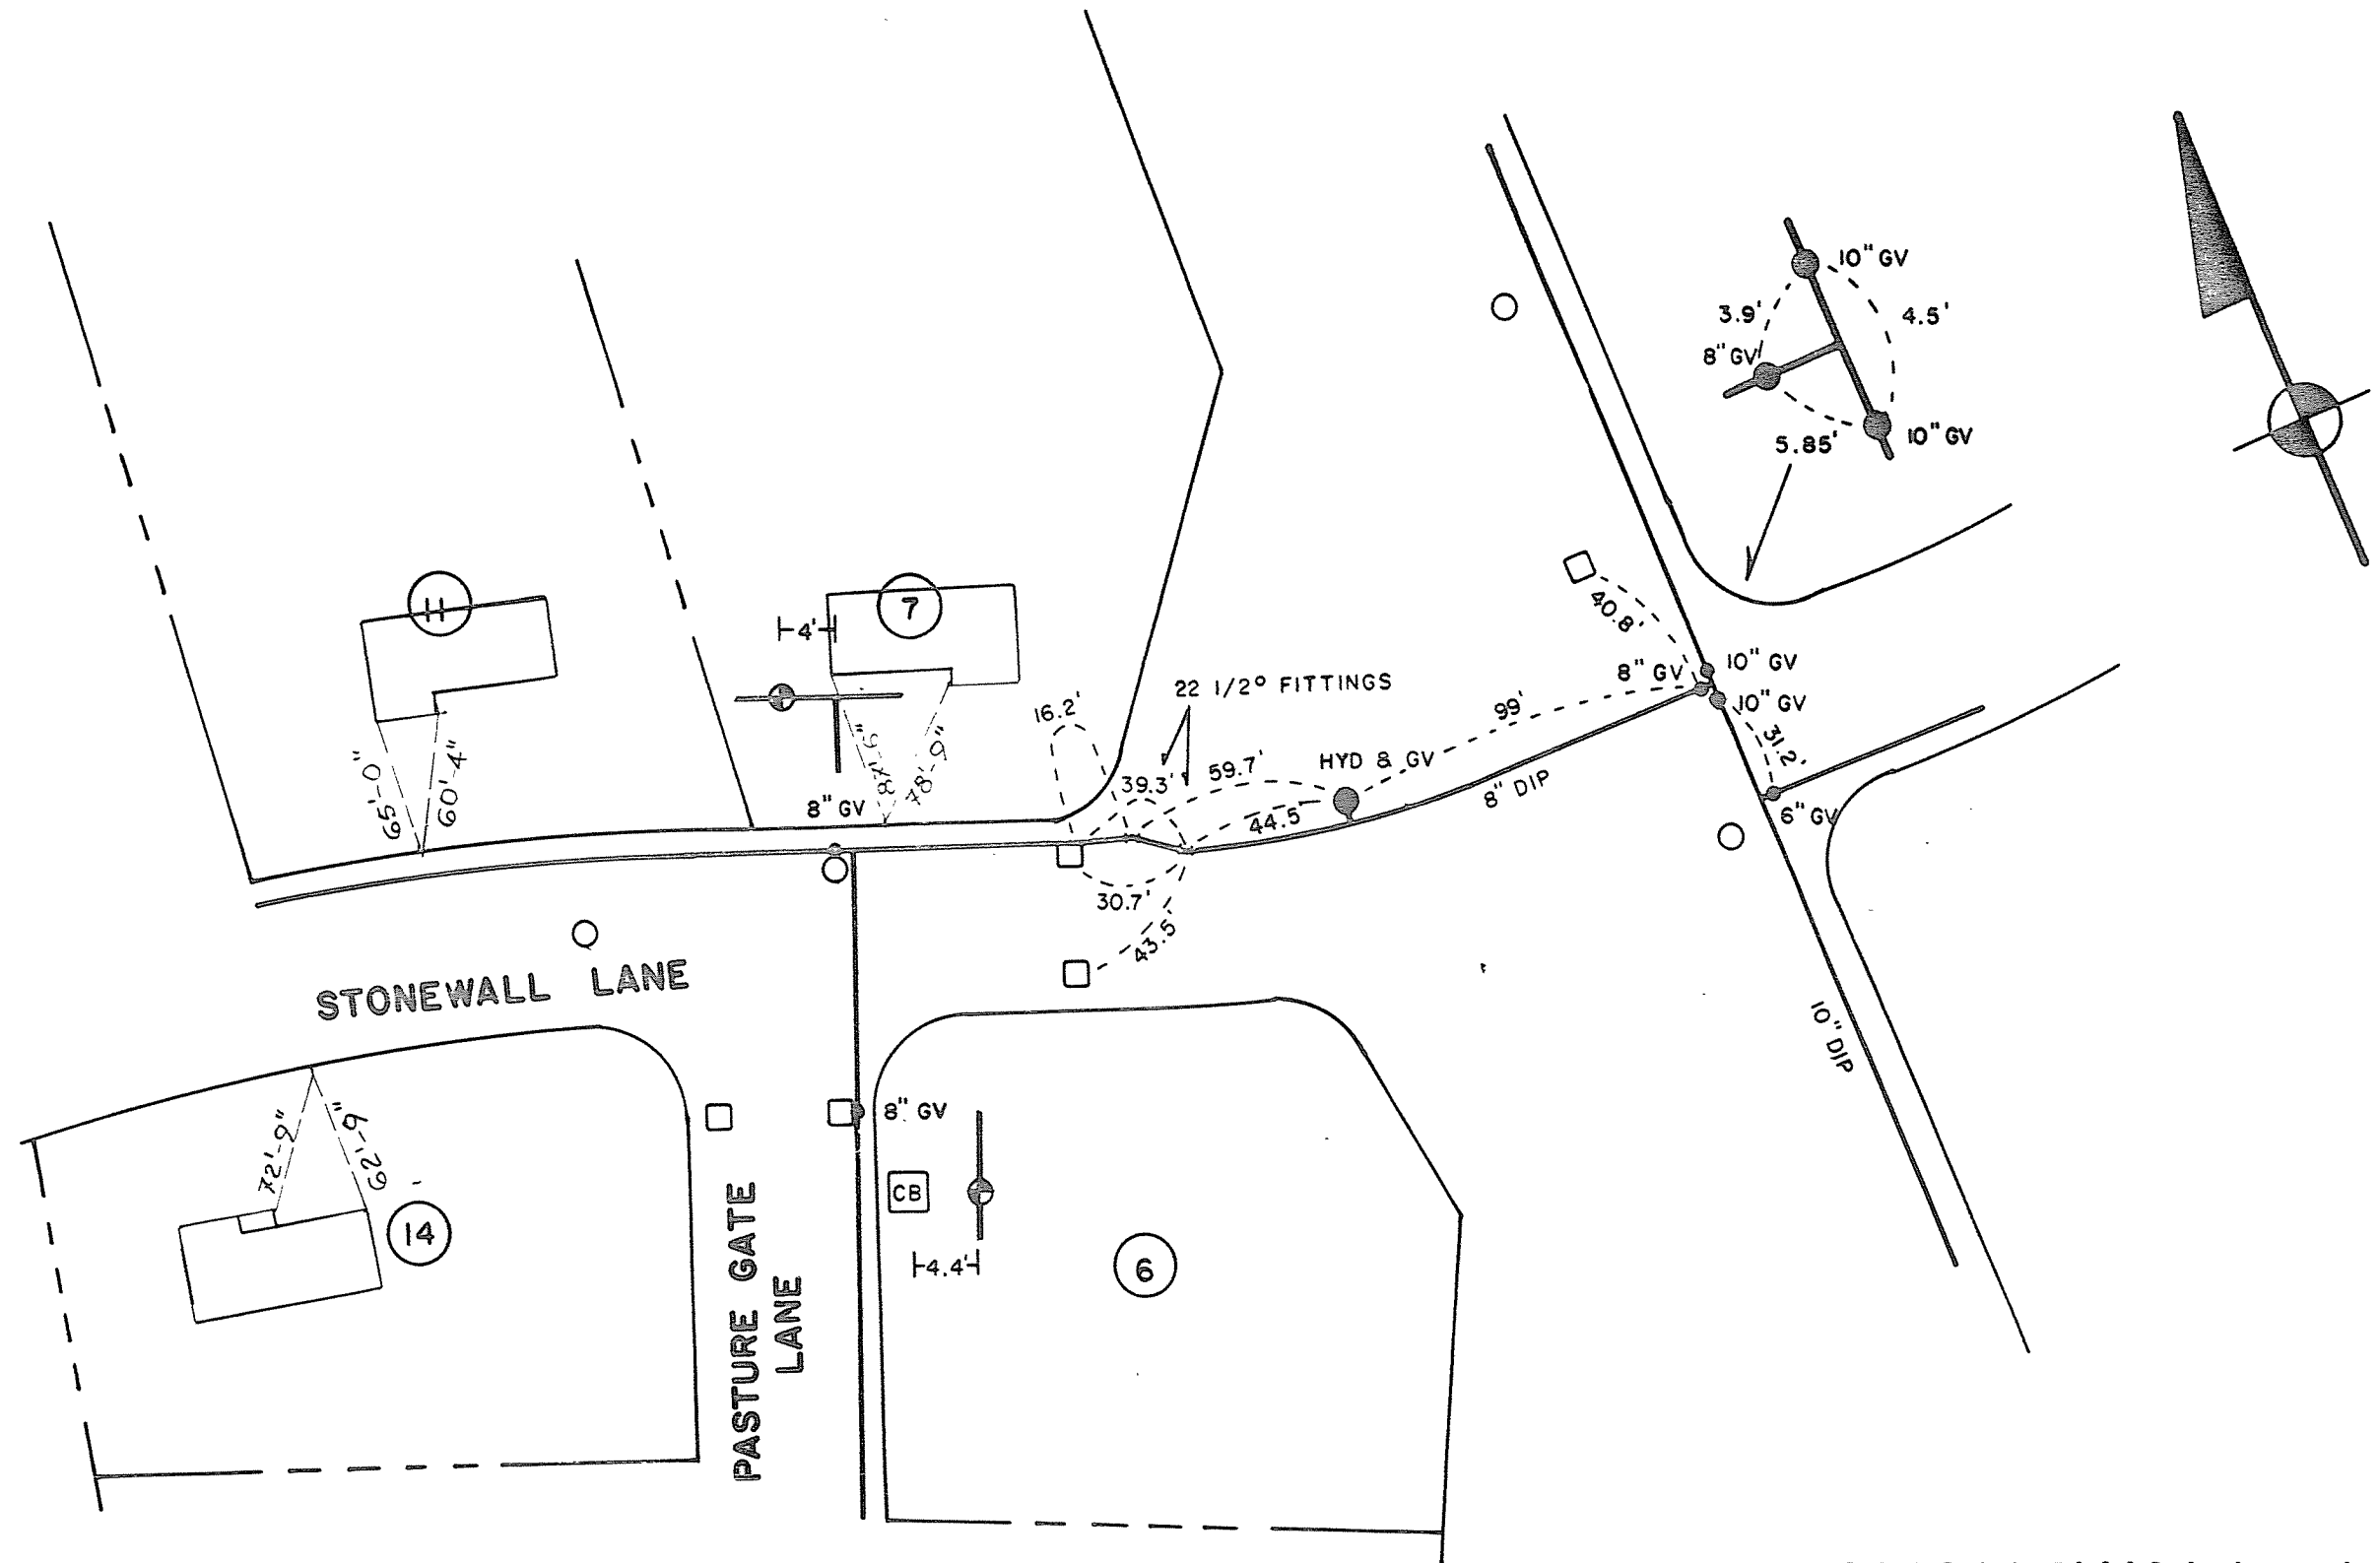

STONEWALL LANE

WATER MAIN & CURB
BOXES
MARCH 1988

1" = 50'