


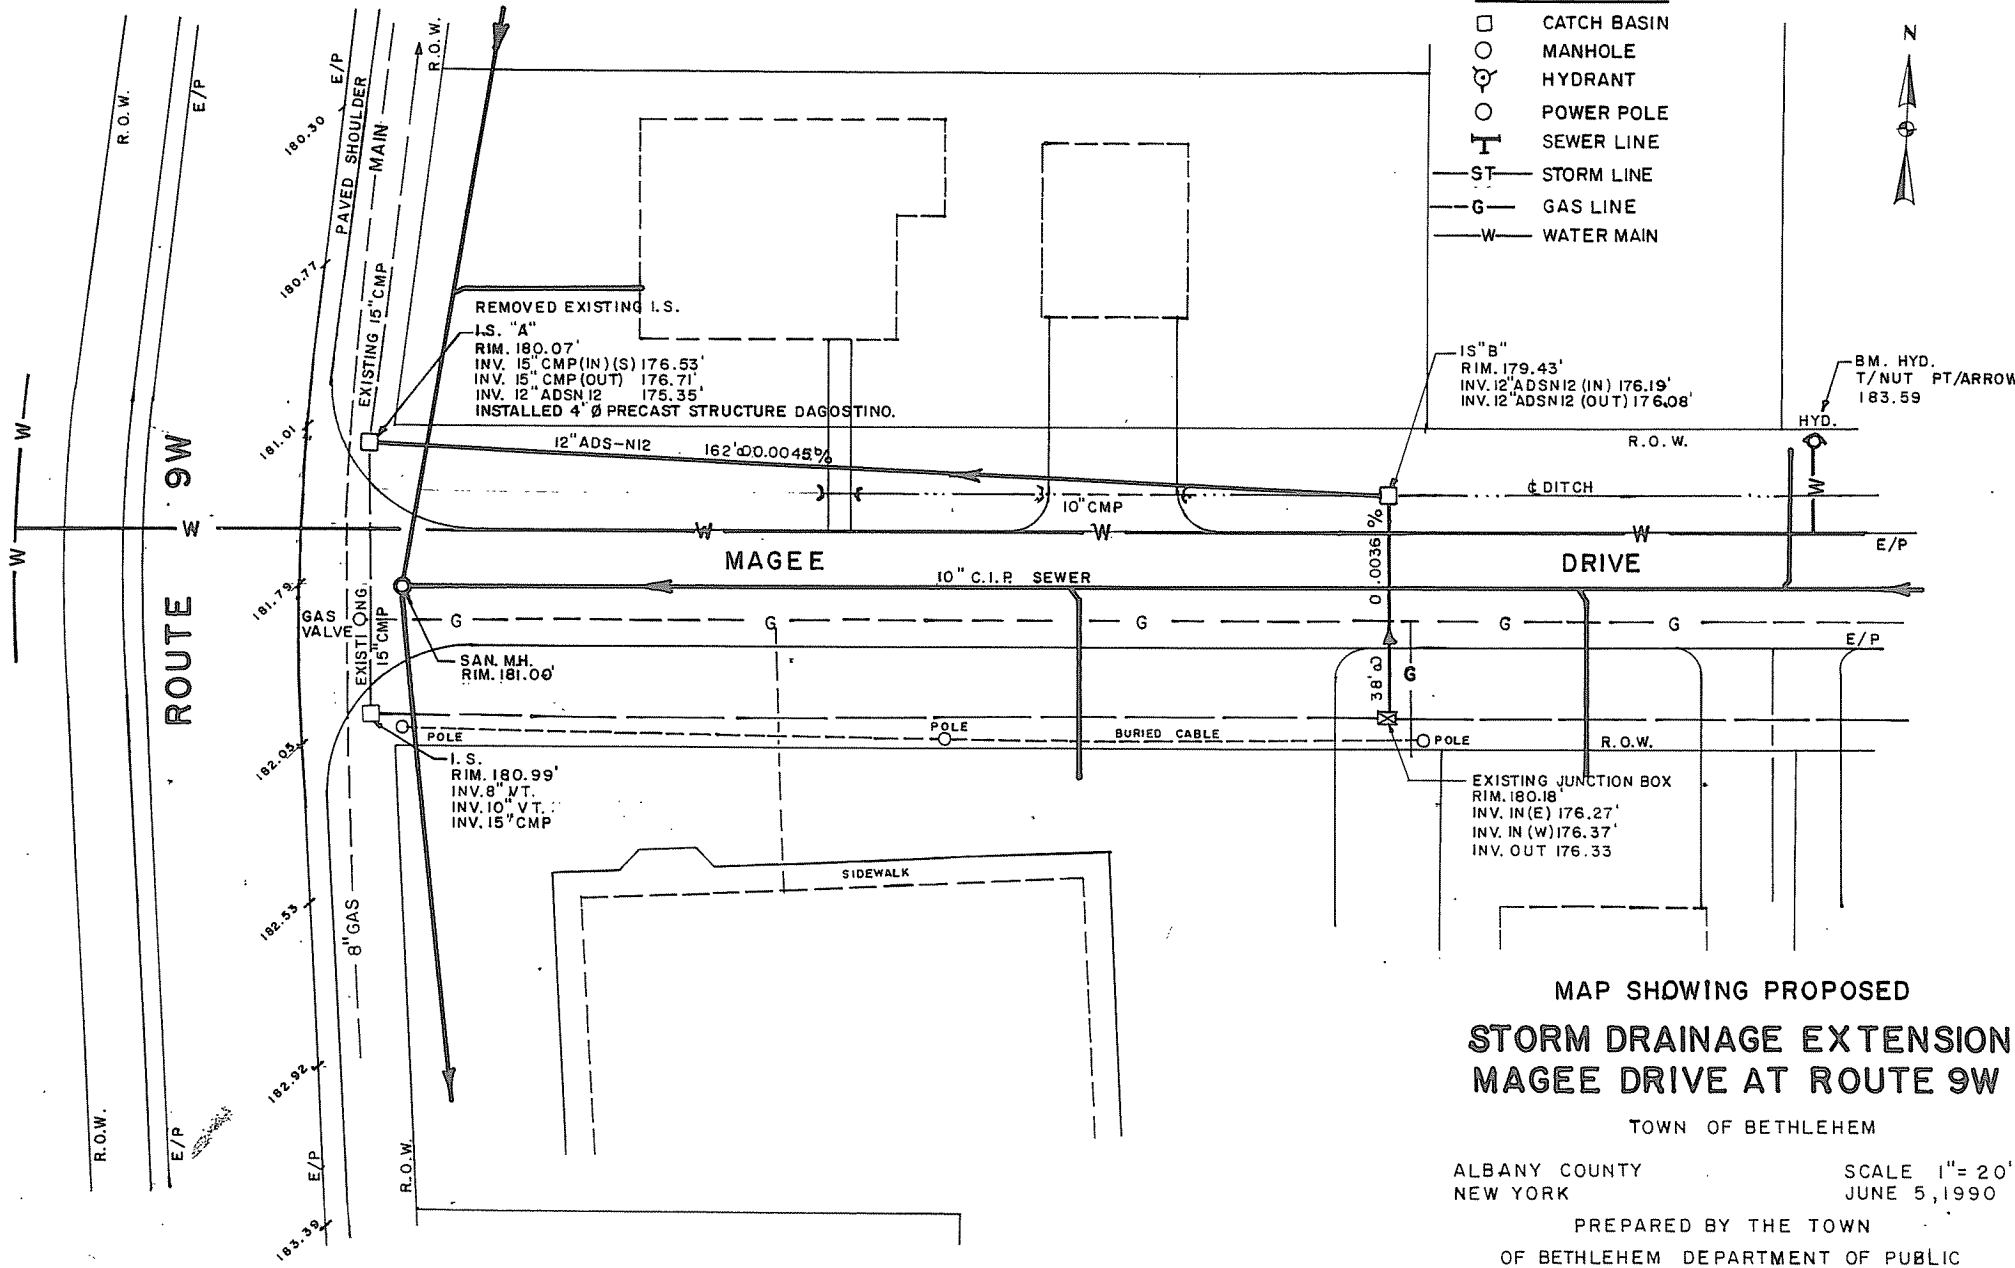

- LEGEND
- CATCH BASIN
 - MANHOLE
 - HYDRANT
 - POWER POLE
 - SEWER LINE
 - ST - STORM LINE
 - G - GAS LINE
 - W - WATER MAIN

MAP SHOWING PROPOSED
STORM DRAINAGE EXTENSION
MAGEE DRIVE AT ROUTE 9W

TOWN OF BETHLEHEM

ALBANY COUNTY
NEW YORK

SCALE 1" = 20'
JUNE 5, 1990

PREPARED BY THE TOWN
OF BETHLEHEM DEPARTMENT OF PUBLIC
WORKS, ENGINEERING DIVISION
RECORD DRAWING
JAN. 7, 1992

INSTALLED NOV. 1991 BY TOWN HIGHWAY DEPARTMENT