




- LEGEND**
- ⊕ VALVE
  - ⊙ HYDRANT
  - MANHOLE
  - CATCH BASIN
  - W— WATER MAIN
  - ▲ THRUST BLOCK

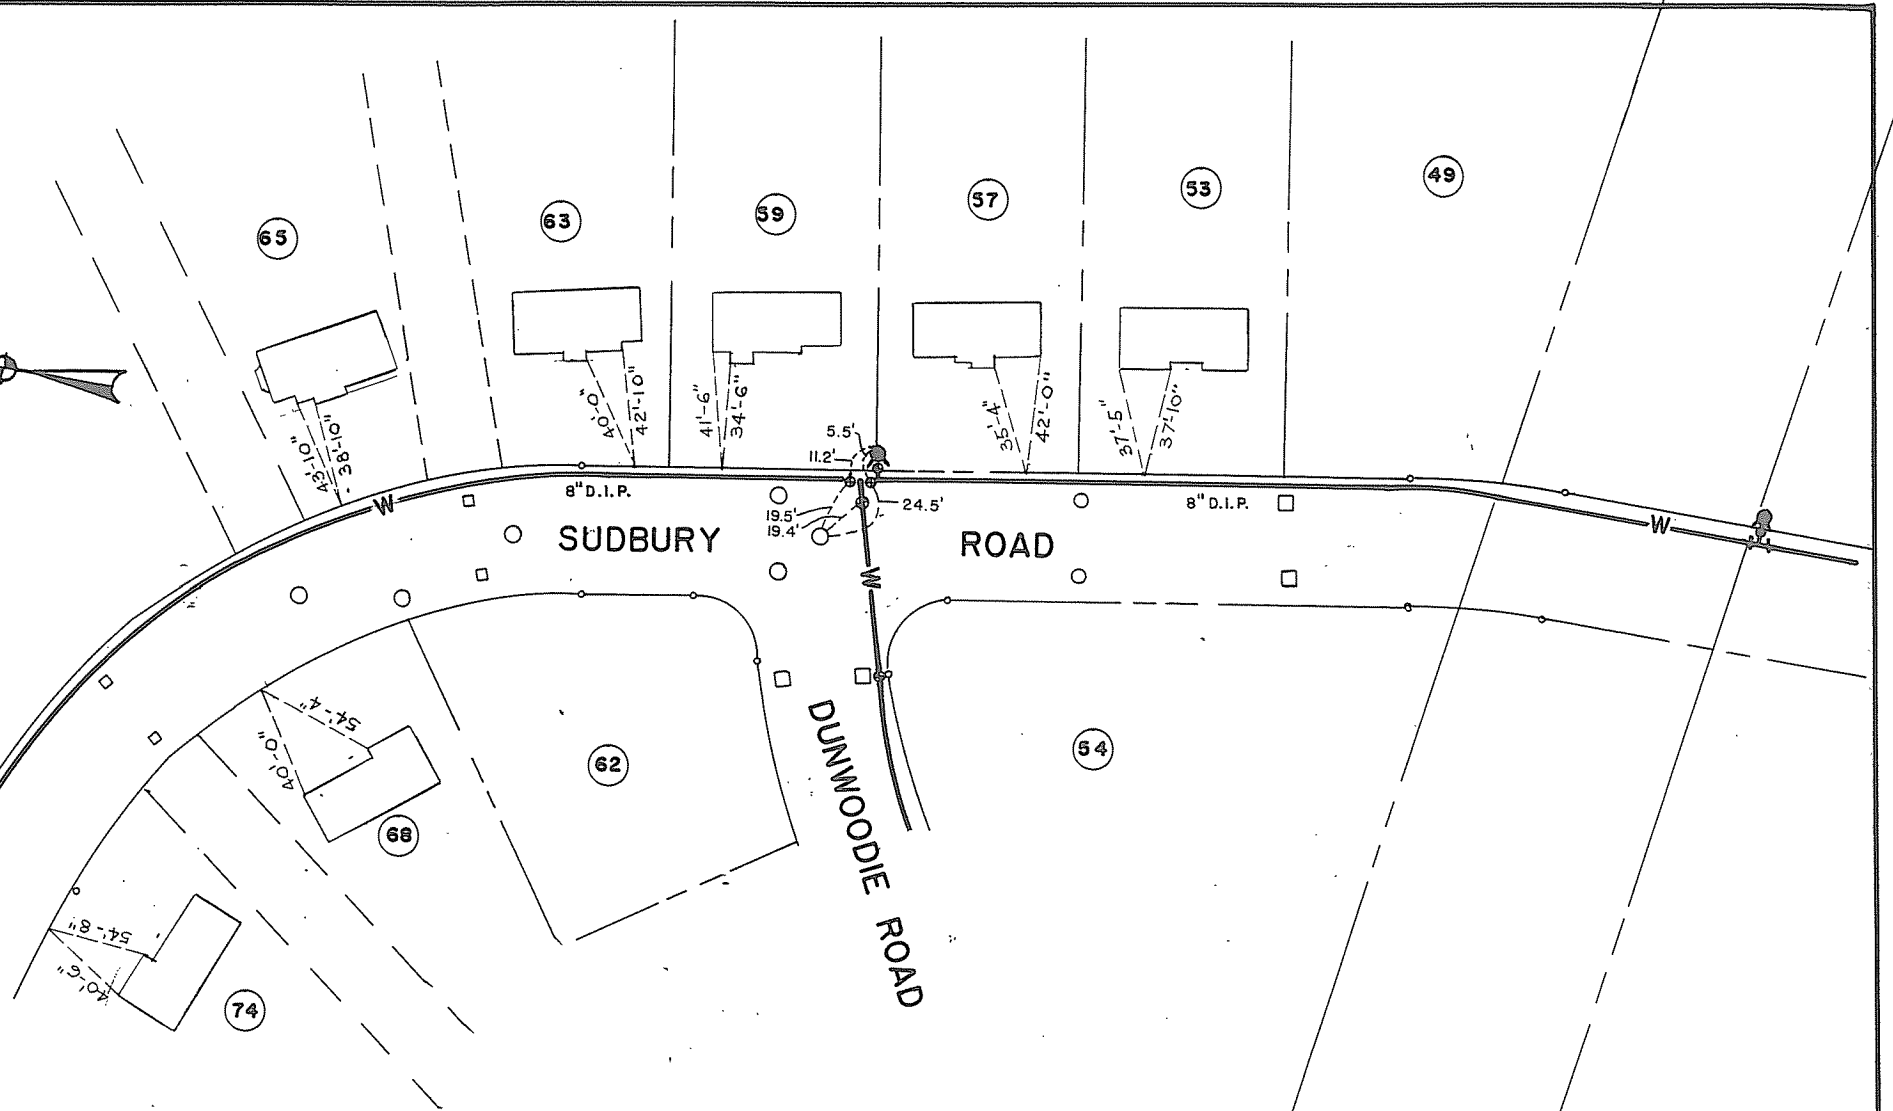

**SUDBURY ROAD  
WATER MAIN**

SCALE: 1" = 50'  
AUG. 1991

CONSTRUCTED BY MICHELI CONSTRUCTION  
INSPECTED BY T.O.B.