

SURREY MALL

WATER DISTRICT NO. I

TOWN OF BETHLEHEM

RECORD OF INSTALLATION

TOWN OF BETHLEHEM ENGINEERING DEPARTMENT

SCALE : 1" = 50'

JUNE, 1984


DWN. BY: KT

RIDGE

EUSTIS

SURREY

MALL

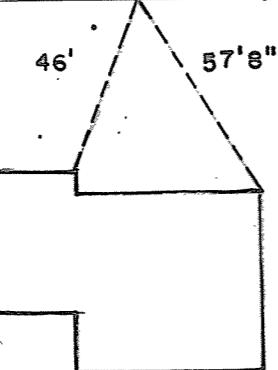

64

60

56

52

48

44

55

51

47

43

35 418