



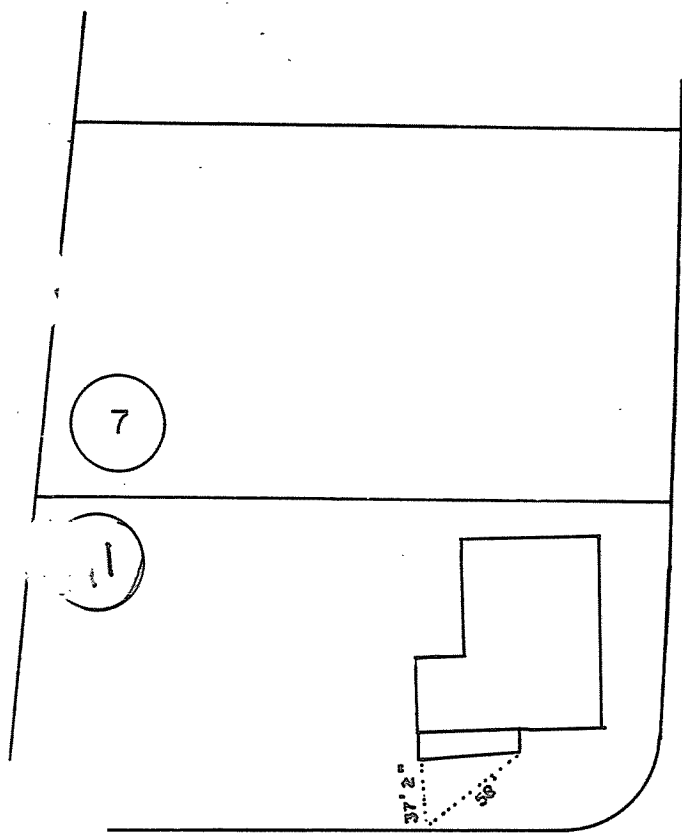


Ridge
Eustis

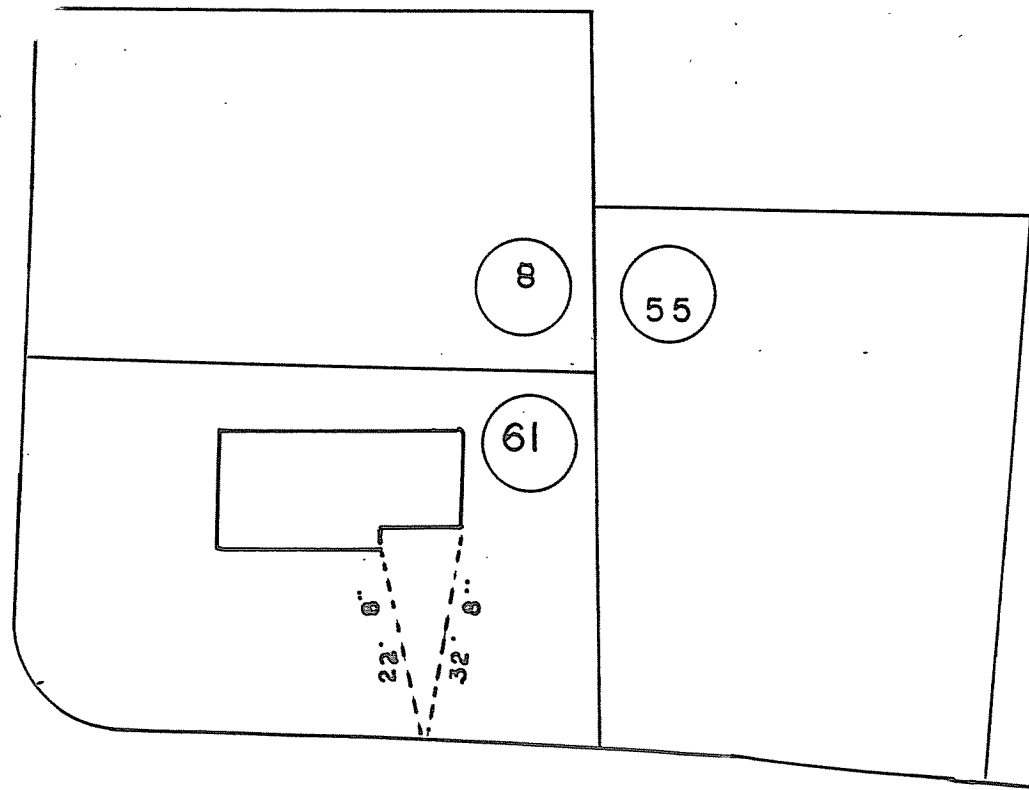

SURREY MALL

SCALE
1" = 50'
DRAWN BY
R E B
APPROVED

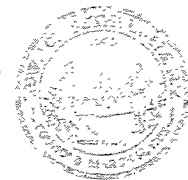

TOWN OF EUSTIS, FLORIDA
ENGINEERING DEPARTMENT
OFFICE OF THE TOWN ENGINEER

Surrey

Mall

