


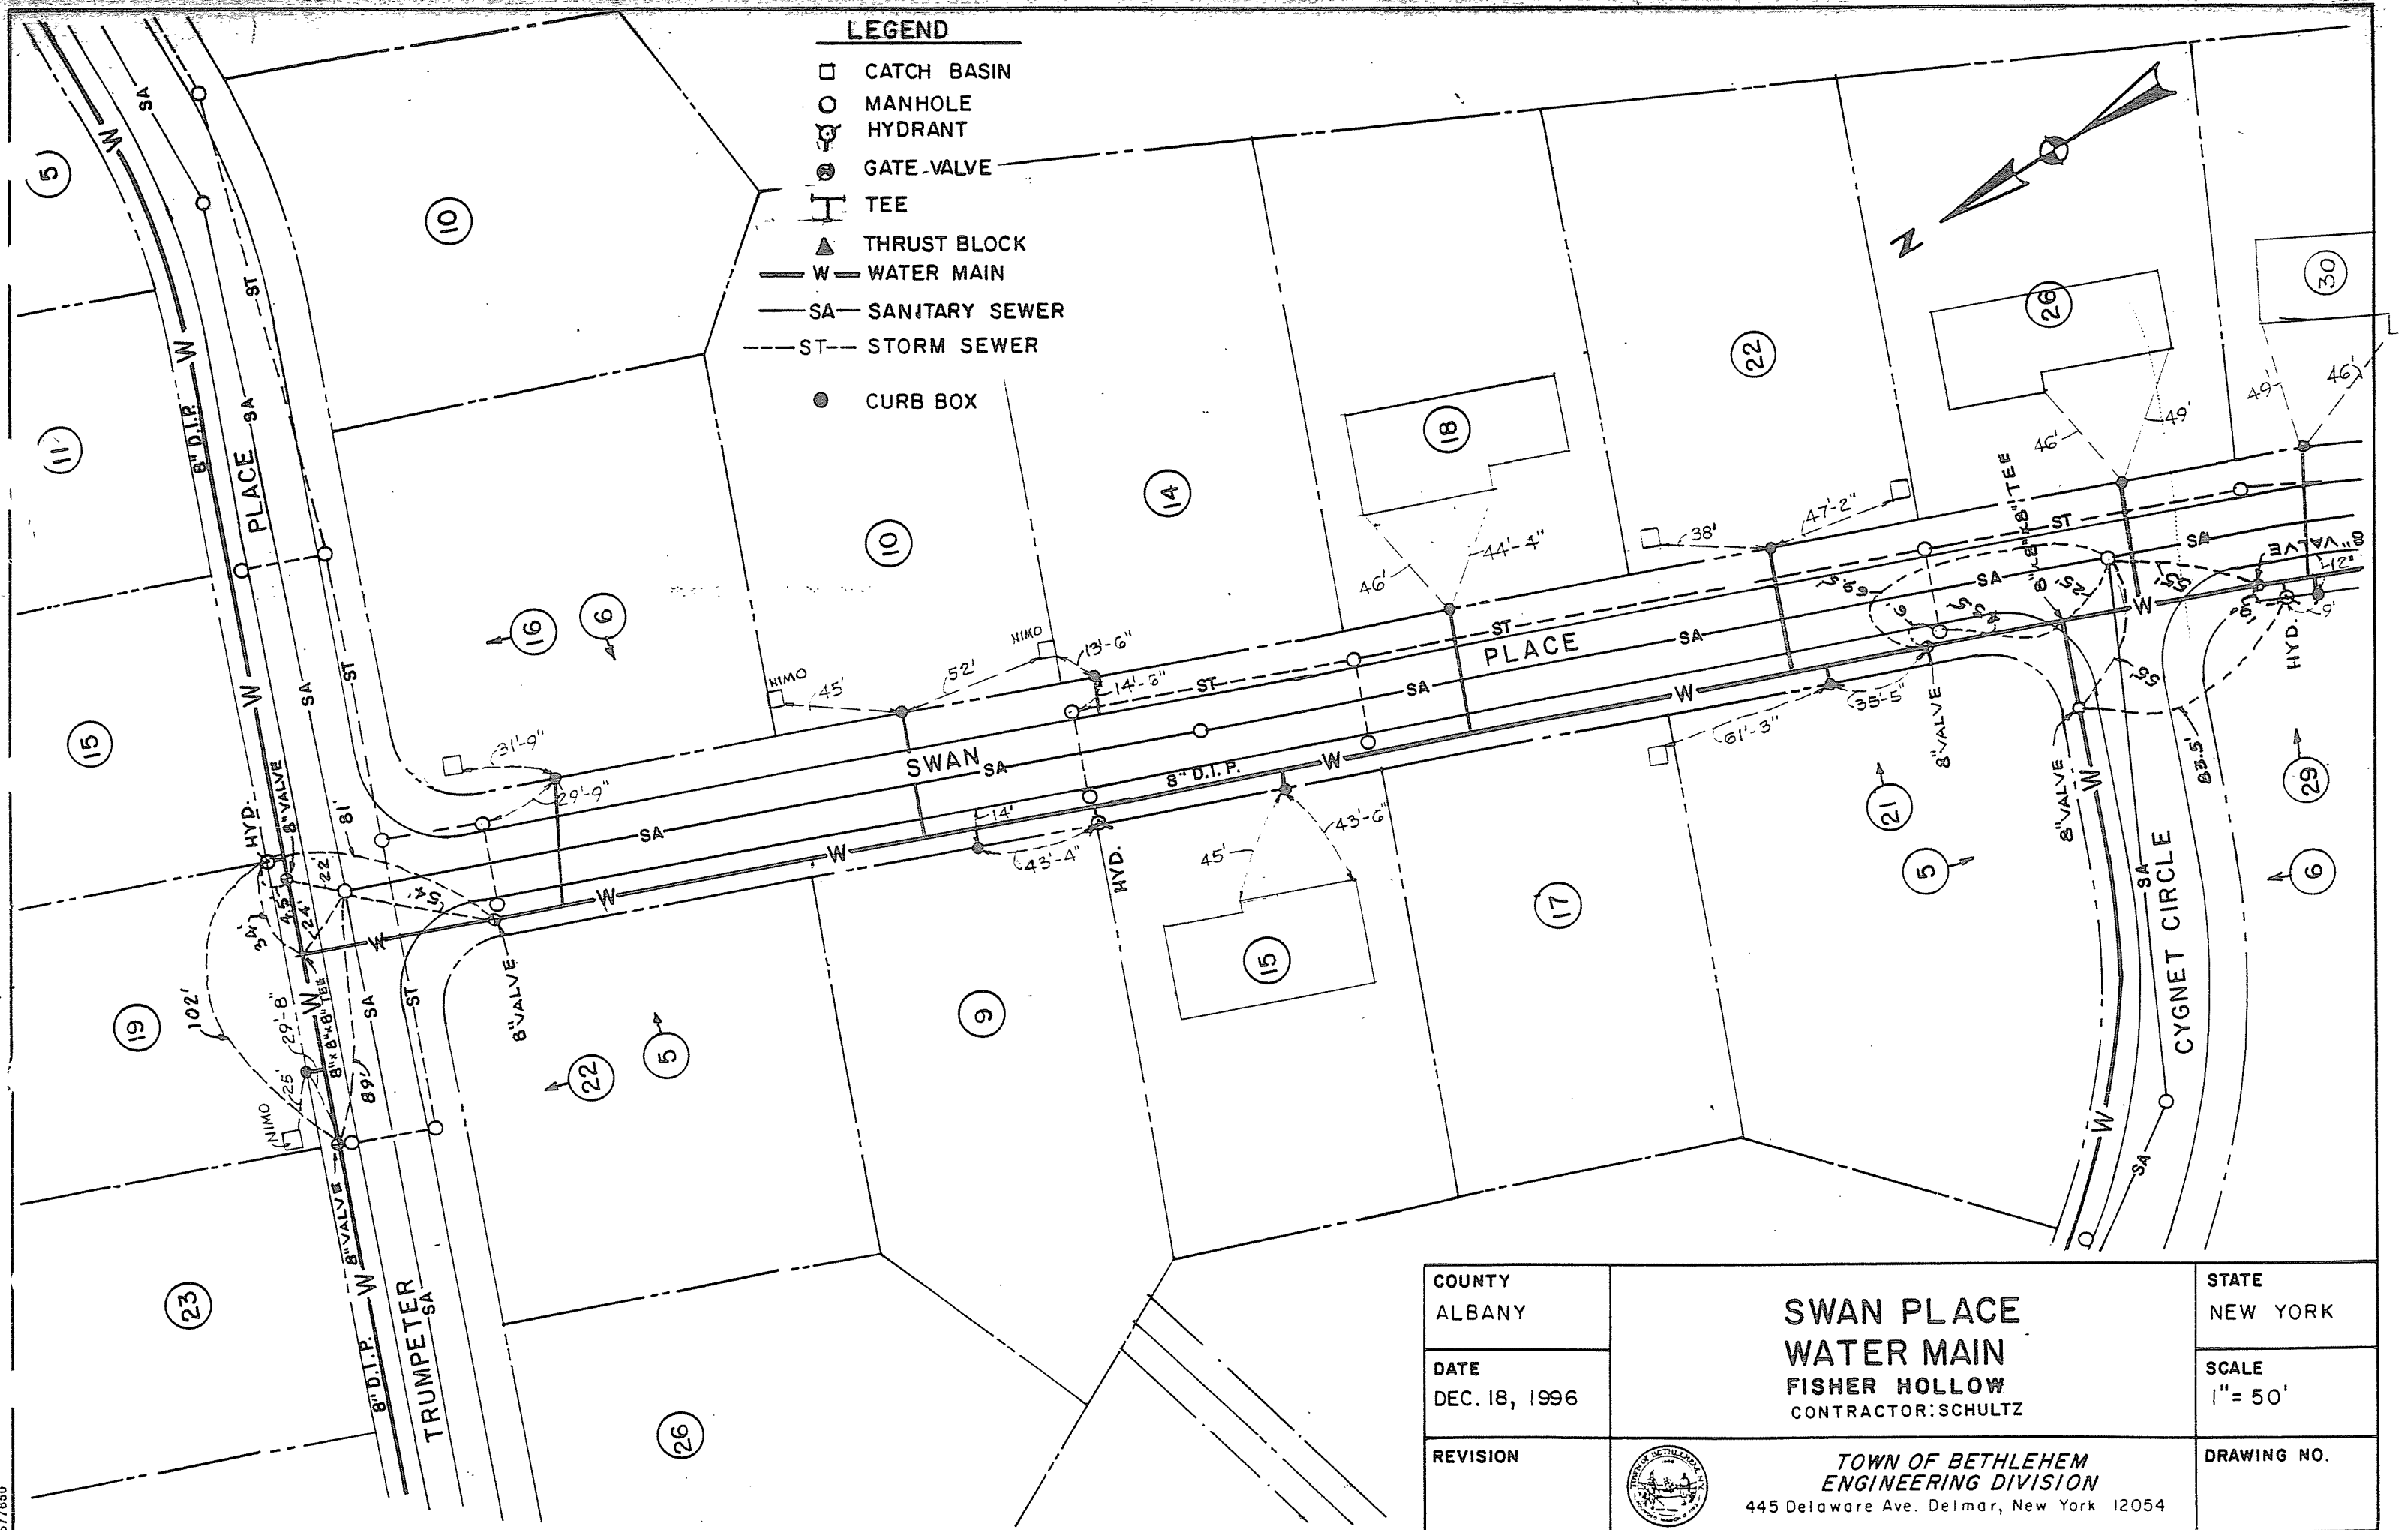

- LEGEND**
- CATCH BASIN
 - MANHOLE
 - HYDRANT
 - GATE VALVE
 - TEE
 - THRUST BLOCK
 - W — WATER MAIN
 - SA — SANITARY SEWER
 - ST — STORM SEWER
 - CURB BOX

COUNTY ALBANY	SWAN PLACE WATER MAIN FISHER HOLLOW CONTRACTOR: SCHULTZ	STATE NEW YORK
DATE DEC. 18, 1996		SCALE 1" = 50'
REVISION	TOWN OF BETHLEHEM ENGINEERING DIVISION 445 Delaware Ave. Delmar, New York 12054	DRAWING NO.



FISHER HOLLOW

577650