


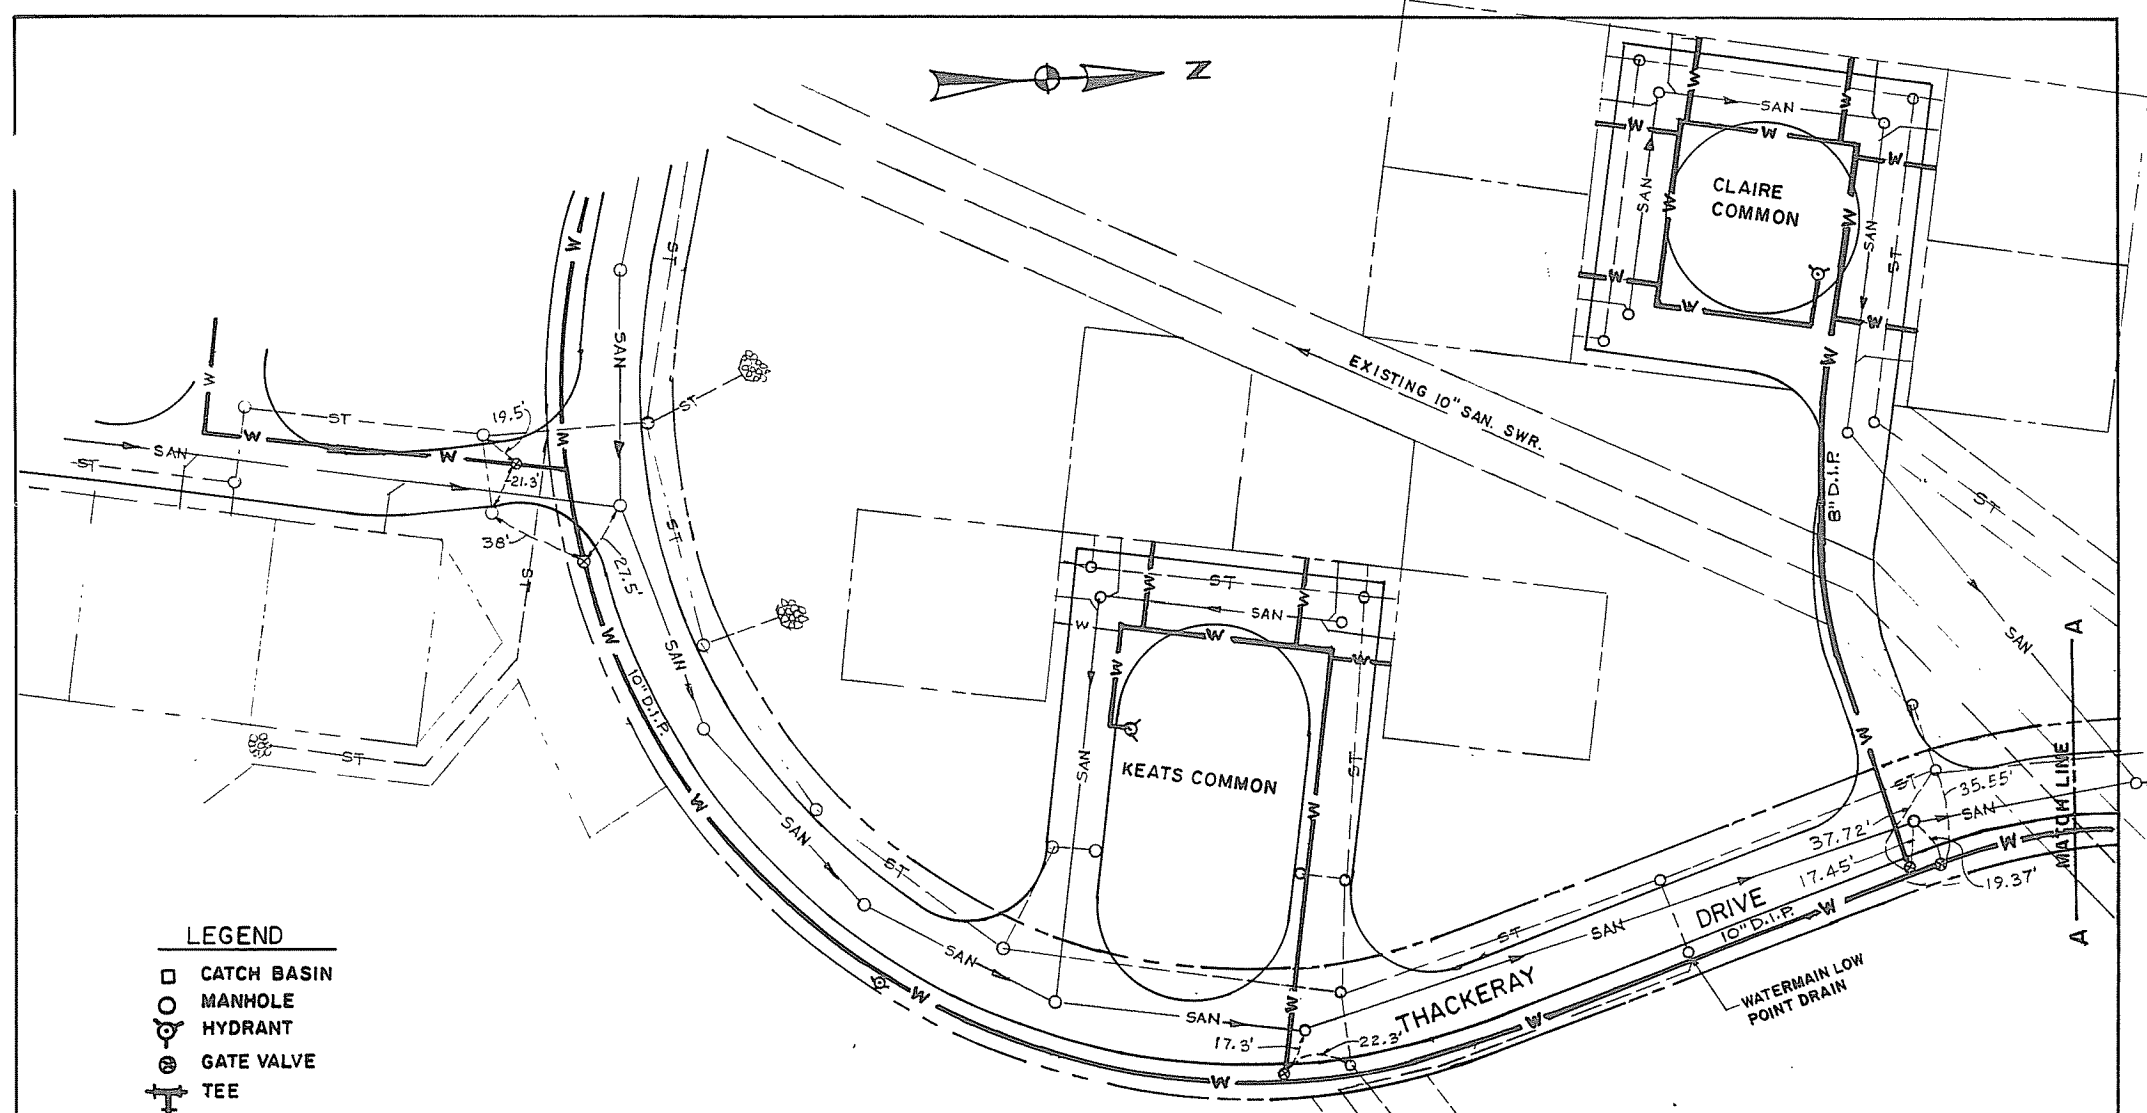

LEGEND

- CATCH BASIN
- MANHOLE
- ⊙ HYDRANT
- ⊕ GATE VALVE
- ⊕ TEE
- ▲ THRUST BLOCK
- W— WATER MAIN
- ST--- STORM SEWER
- SA— SANITARY SEWER
- CURB BOX

COUNTY ALBANY	THACKERAY DRIVE TERRAMERE WATER MAIN LOCATION	STATE NEW YORK
DATE JULY 26, 1999		SCALE 1" = 50'
REVISION	 TOWN OF BETHLEHEM ENGINEERING DIVISION 445 Delaware Ave. Delmar, New York 12054	DRAWING NO.