
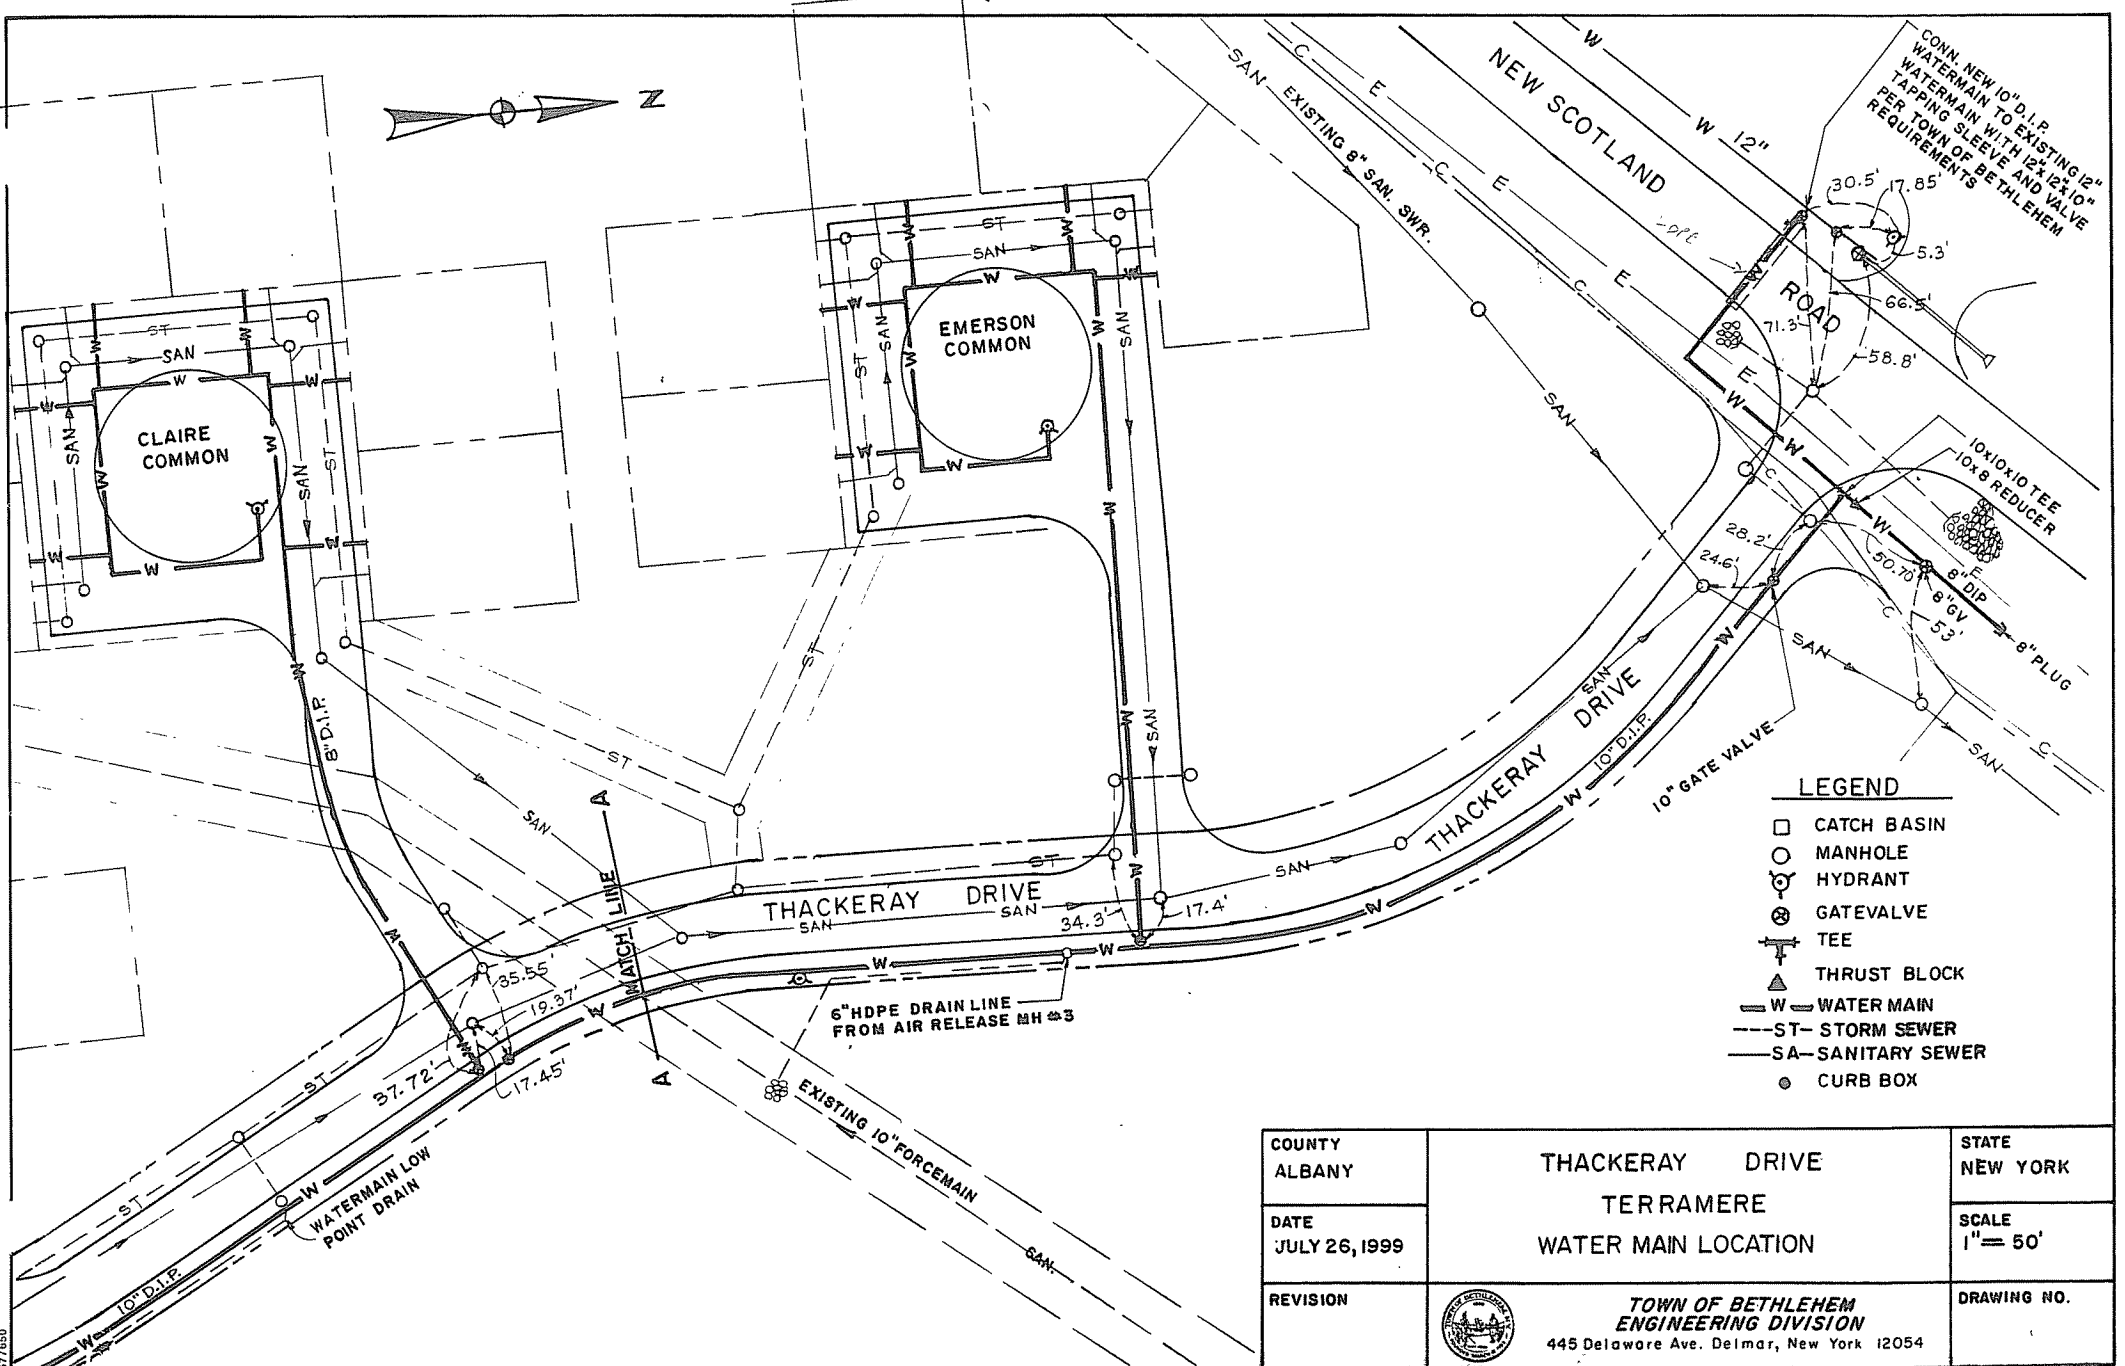


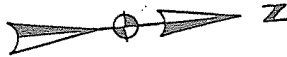

- LEGEND**
- CATCH BASIN
 - MANHOLE
 - ⊙ HYDRANT
 - ⊗ GATE VALVE
 - ⊥ TEE
 - ▲ THRUST BLOCK
 - W — WATER MAIN
 - - - ST - - - STORM SEWER
 - - - SA - - - SANITARY SEWER
 - CURB BOX

COUNTY ALBANY	THACKERAY DRIVE TERRAMERE WATER MAIN LOCATION	STATE NEW YORK
DATE JULY 26, 1999		SCALE 1" = 50'
REVISION	 TOWN OF BETHLEHEM ENGINEERING DIVISION 445 Delaware Ave. Delmar, New York 12054	DRAWING NO.

577650