



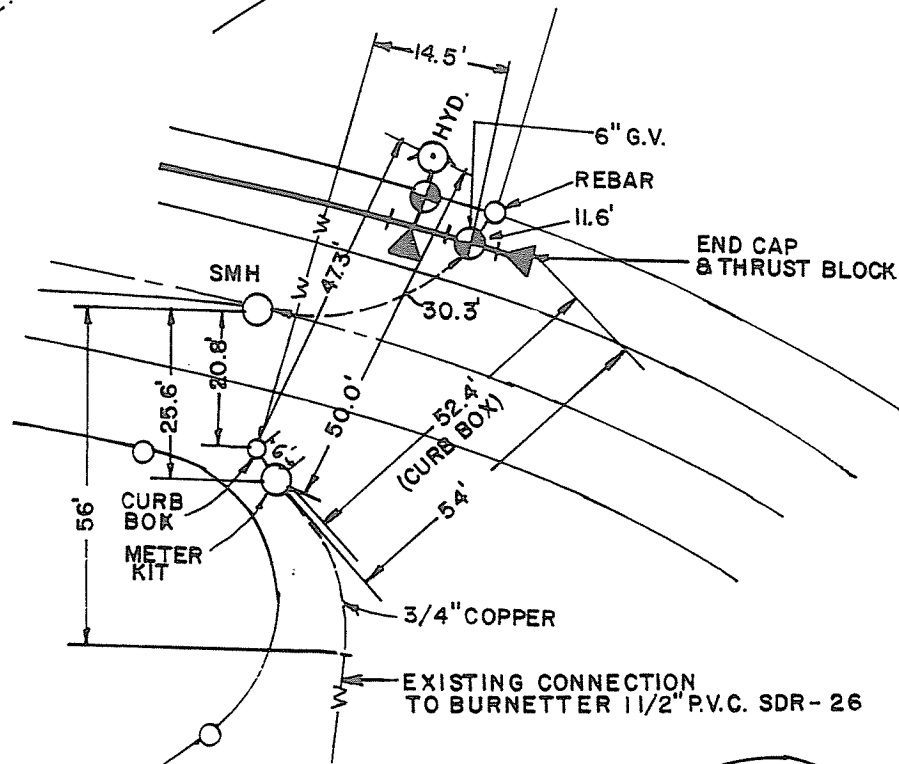

2" MORRISSEY
WATER SERVICE

NOTE:
THE DISTANCE FROM THE 6" G.V.
TO THE 22 1/2° BEND = 57'
THE 6" x 6" TEE = 91'

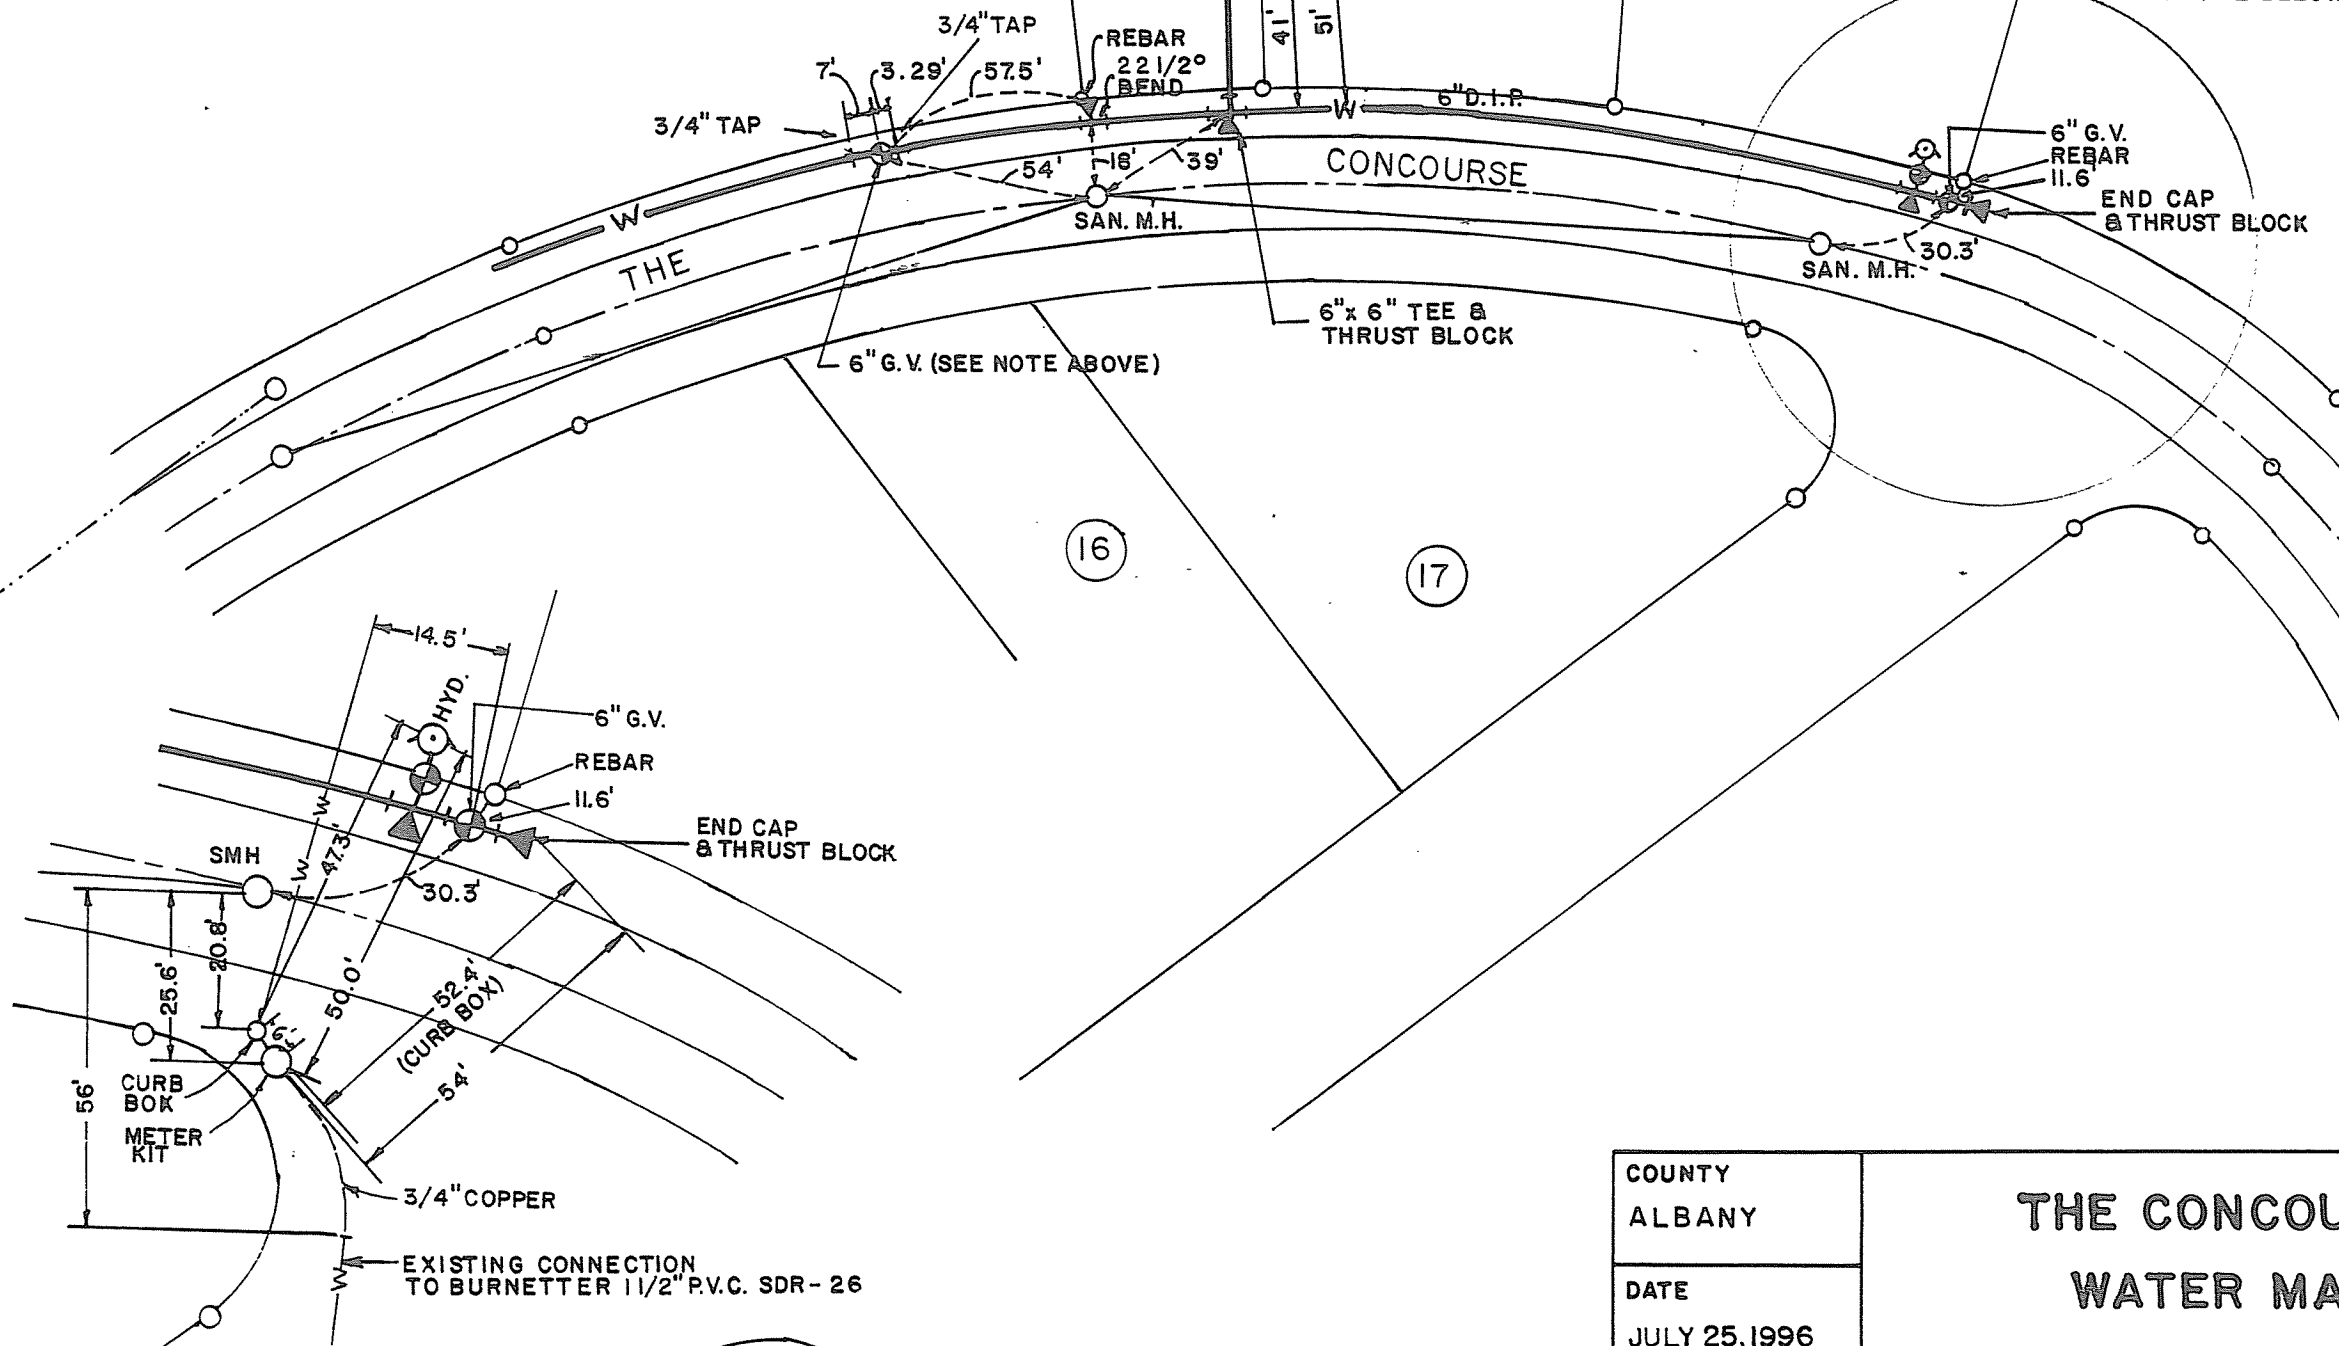

COUNTY ALBANY	THE CONCOURSE WATER MAIN	STATE NEW YORK
DATE JULY 25, 1996		SCALE 1" = 50'
REVISION	 TOWN OF BETHLEHEM ENGINEERING DIVISION 445 Delaware Ave. Delmar, New York 12054	DRAWING NO. 1