
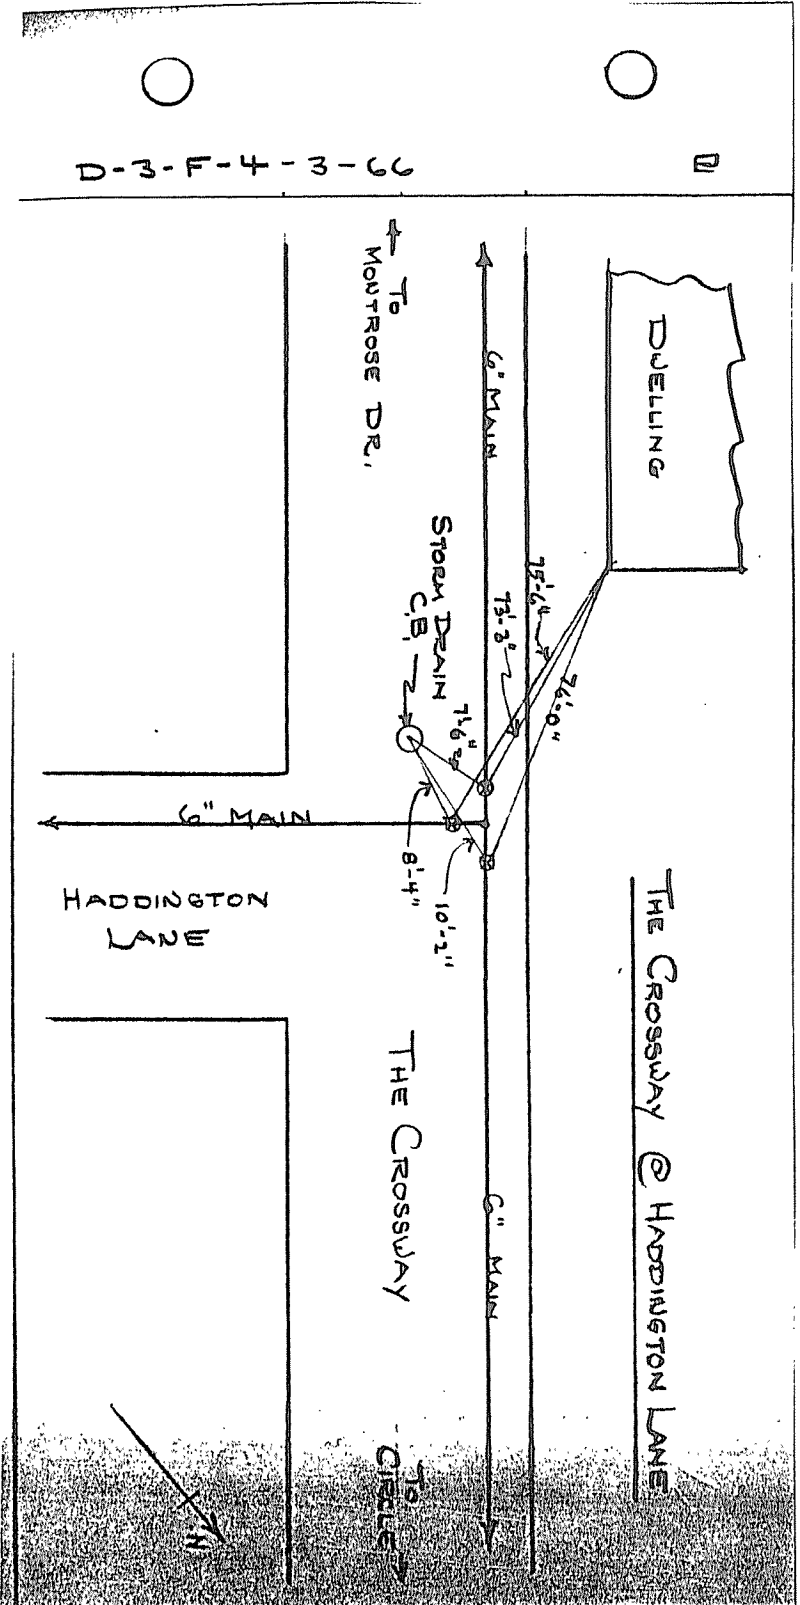


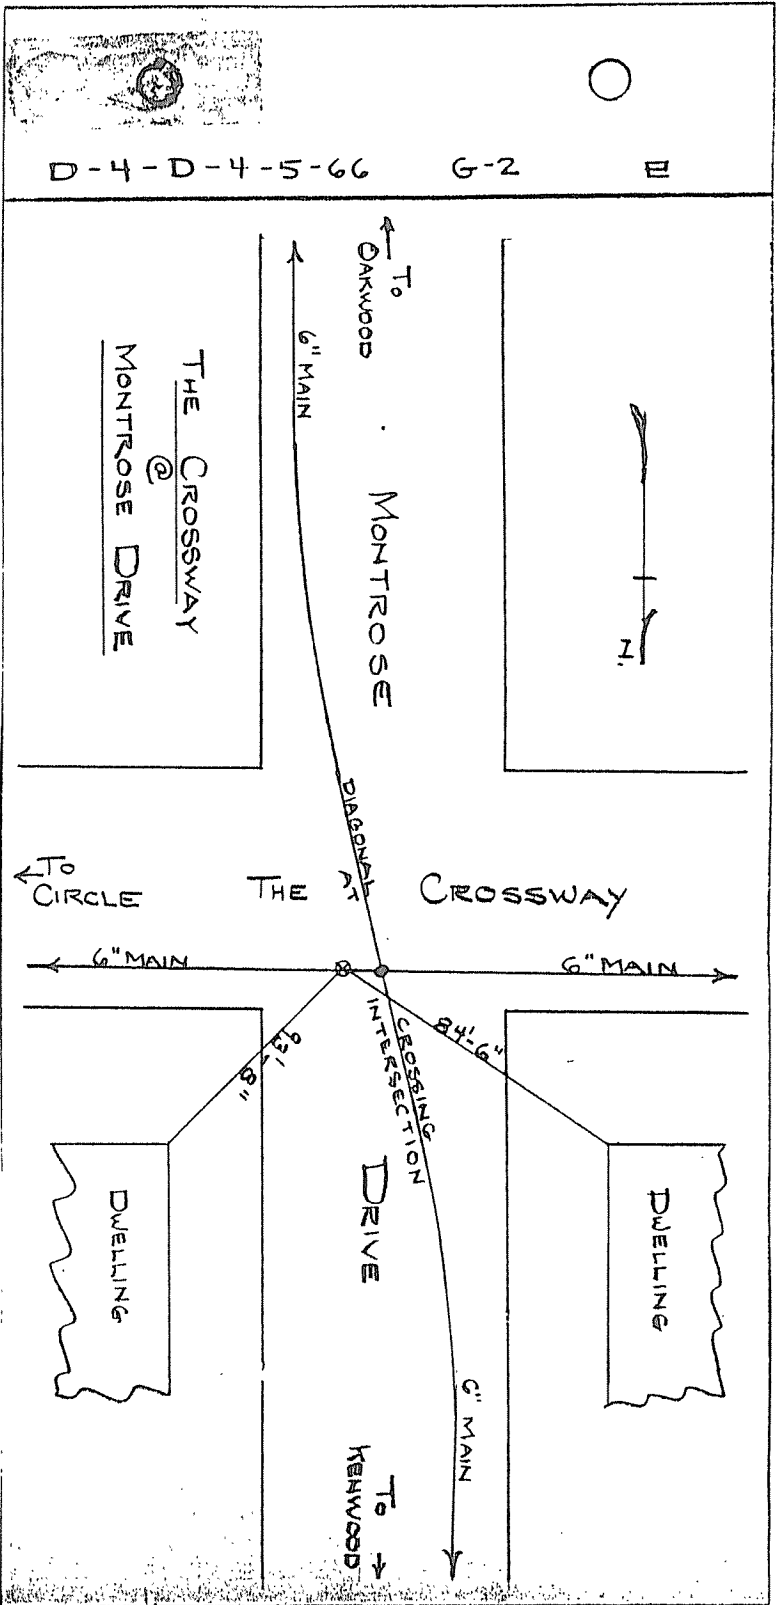

THE CROSSWAY
WATER MAIN