


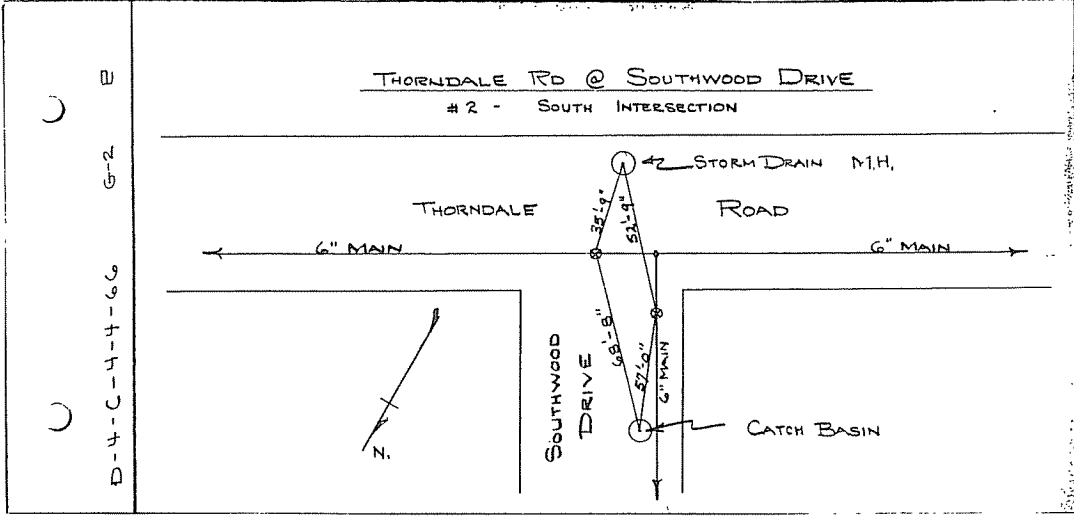

THORNDALE ROAD
 WATER MAIN