


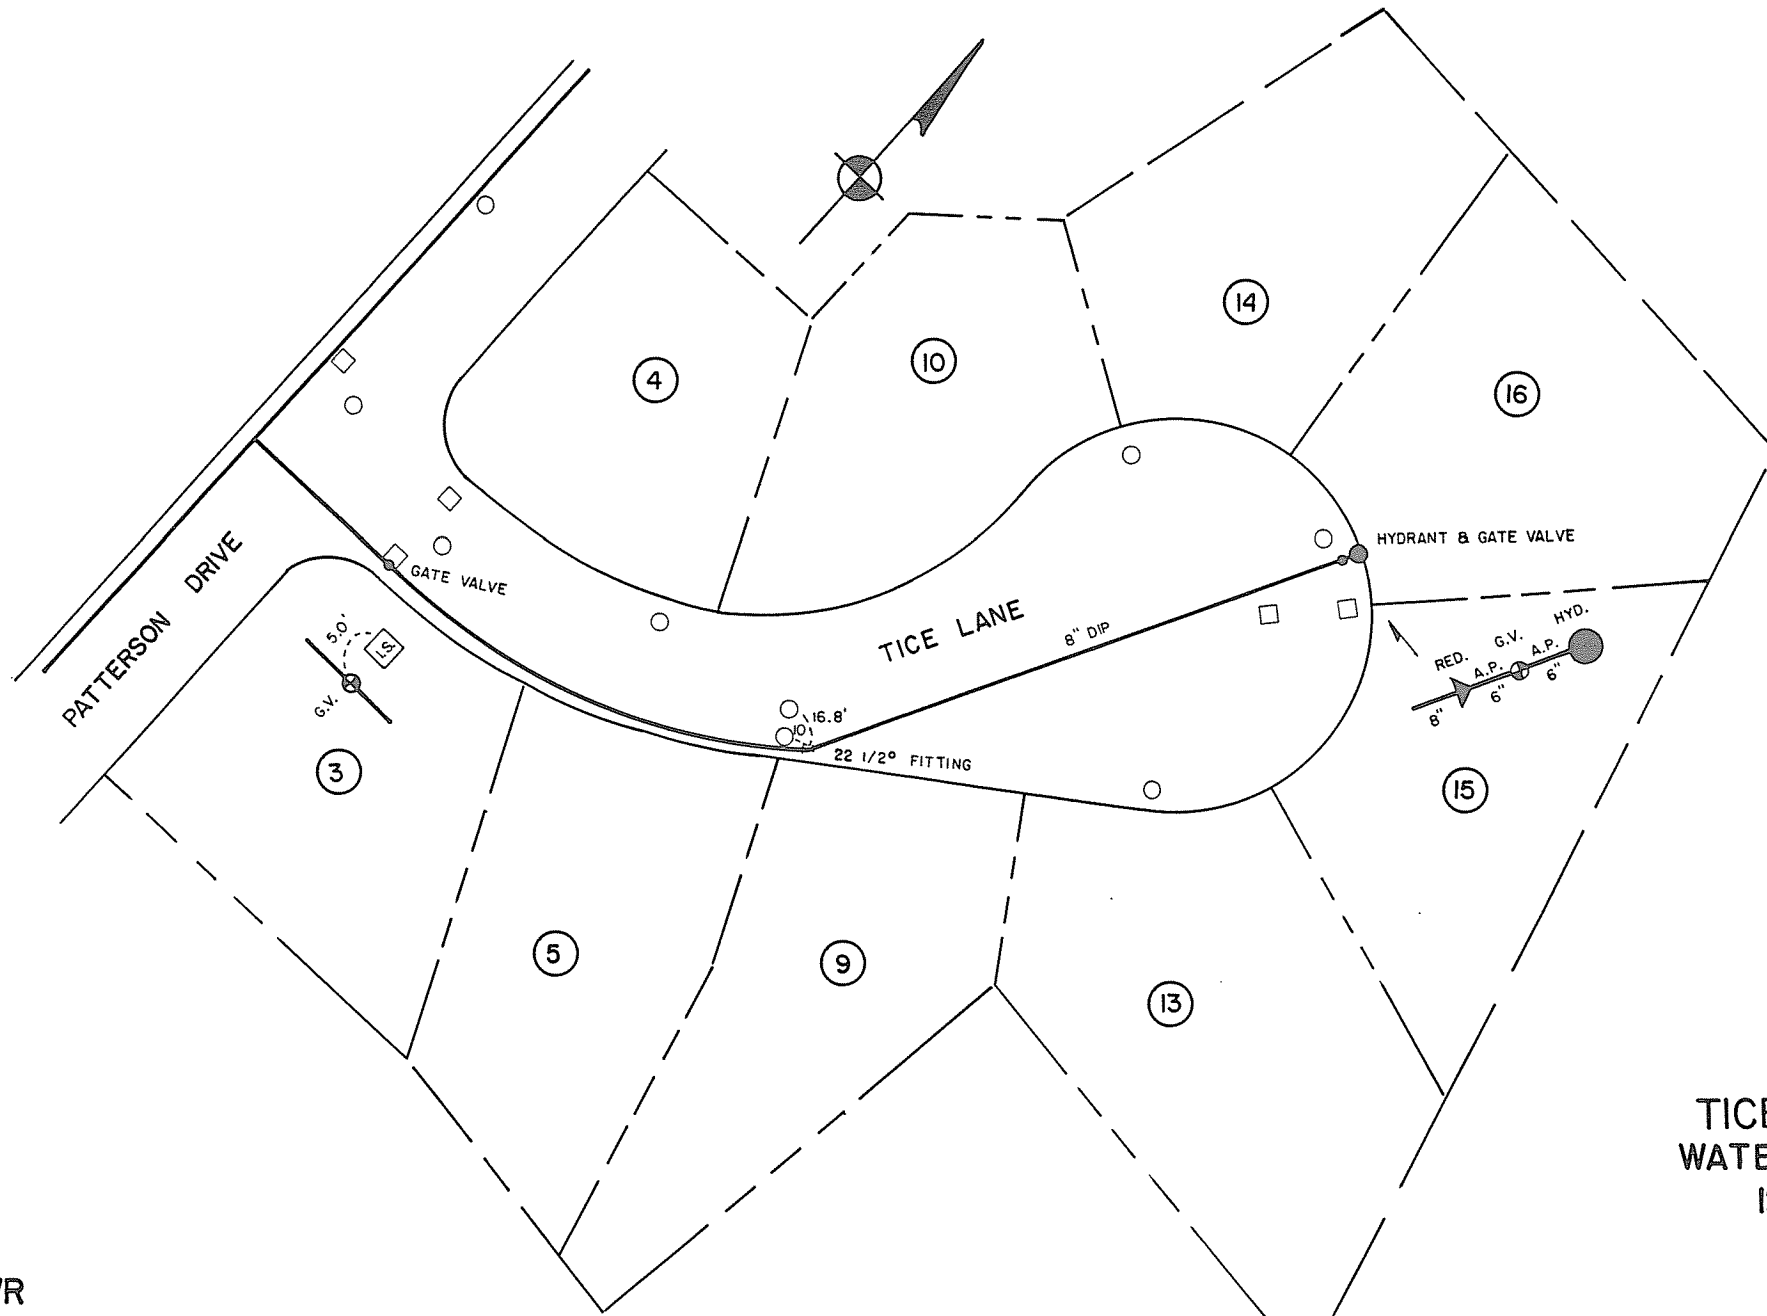

TICE LANE
WATER MAINS
12/88