


LEGEND

- CATCH BASIN
- MANHOLE
- ⊙ HYDRANT
- ⊕ GATE VALVE
- T TEE
- ▲ TRUSS BLOCK
- W— WATER MAIN
- SA— SANITARY SEWER
- ST--- STORM SEWER

NOTE:
ALL WATER MAINS SHALL BE 8" DUCTILE IRON

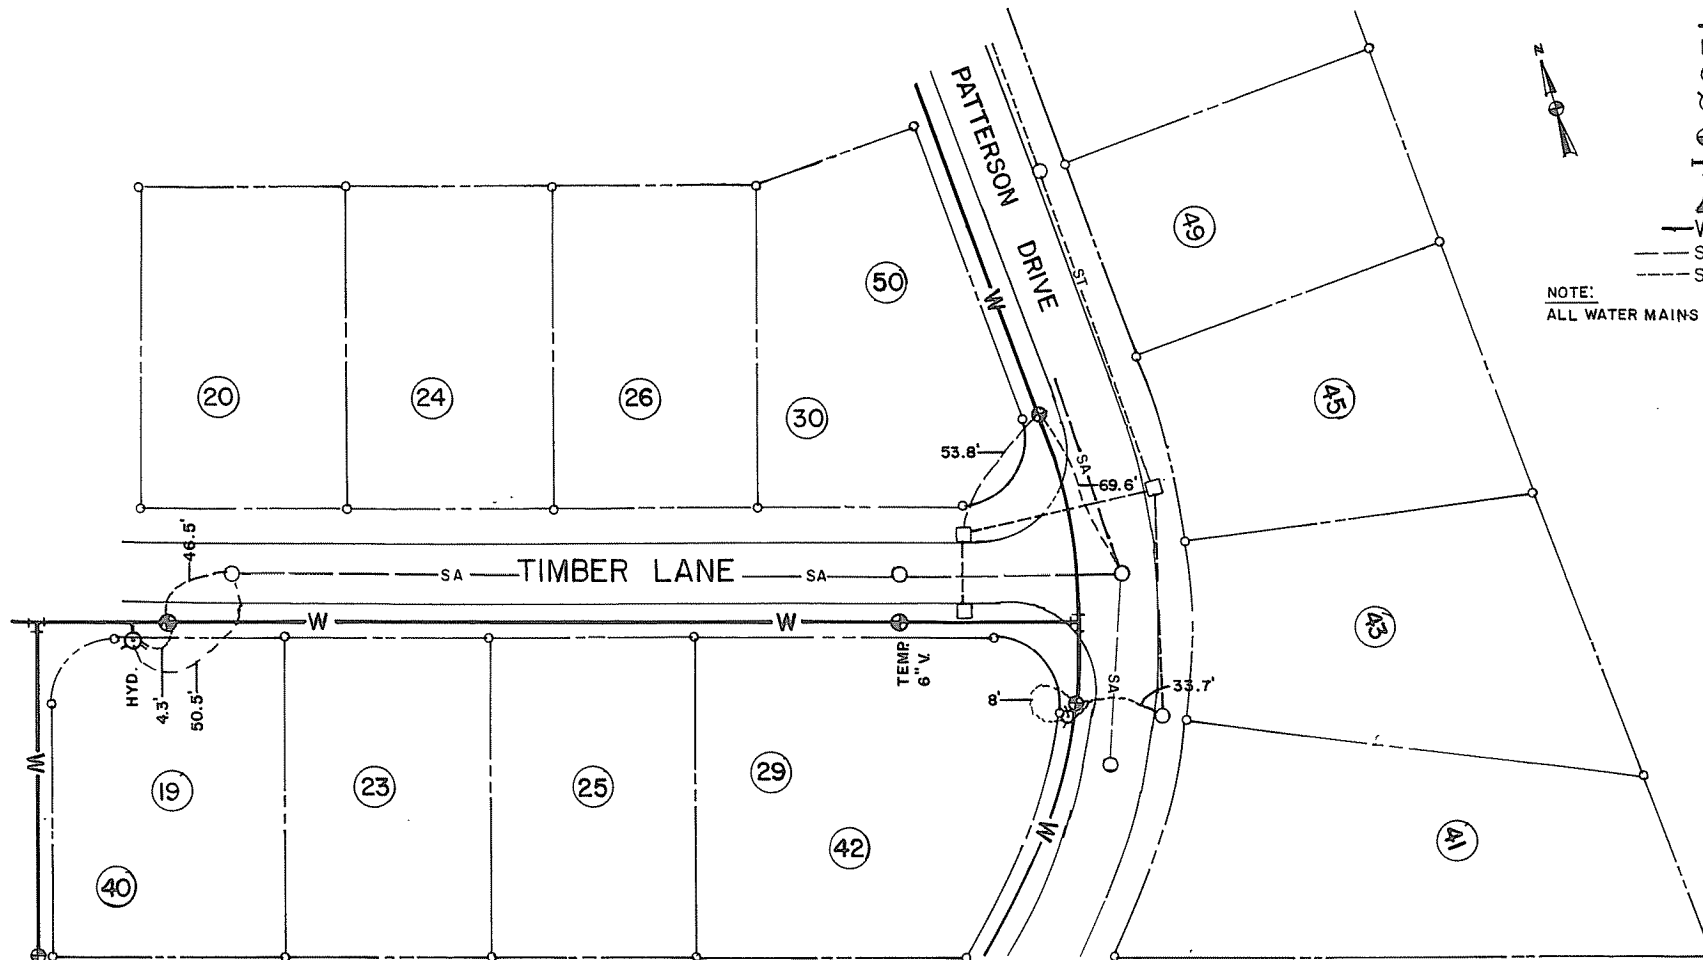

TIMBER LANE WATER MAIN

SCALE: 1"=50'

DATE: JUL.13,1994

CONSTRUCTED BY HARLEN METZ

INSPECTED BY T.O.B.