


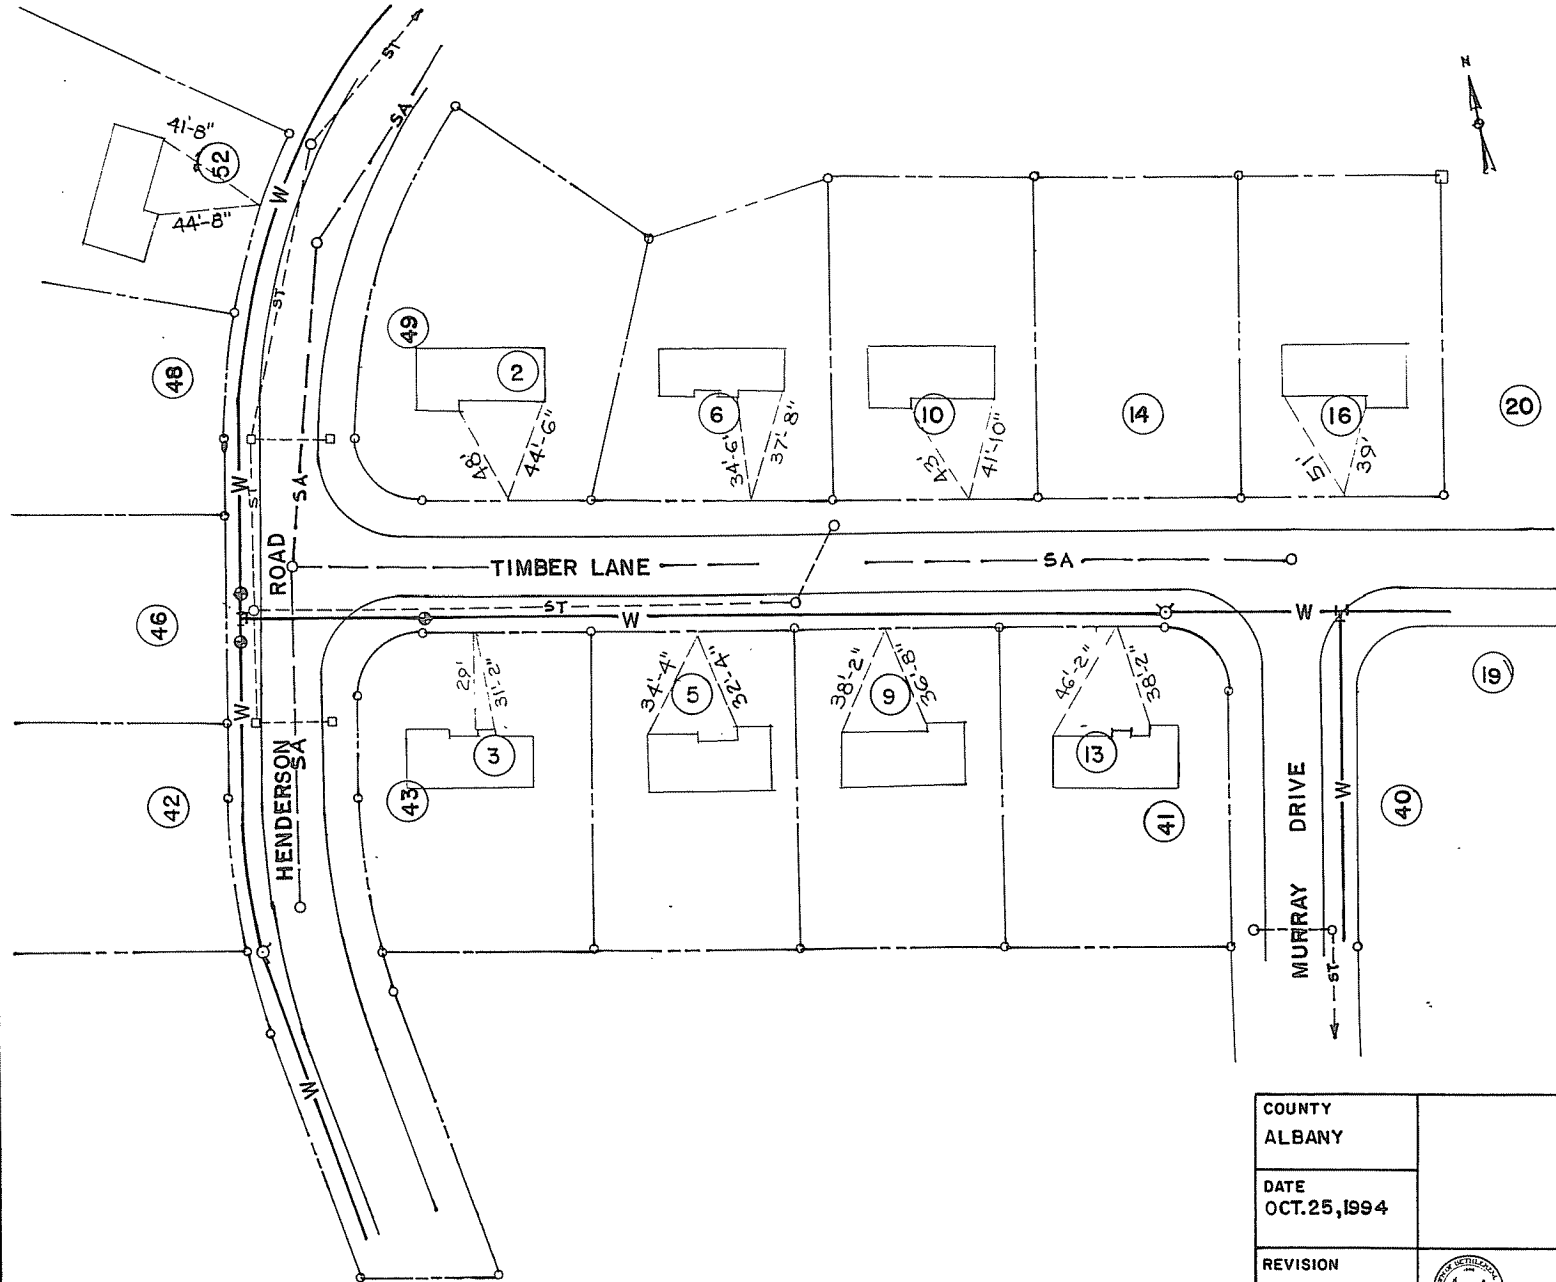

- LEGEND**
- CATCH BASIN
 - MANHOLE
 - ⊕ HYDRANT
 - ⊕ GATE VALVE
 - T TEE
 - ▲ TRUSS BLOCK
 - W— WATER MAIN
 - SA--- SANITARY SEWER
 - ST--- STORM SEWER

NOTE:
ALL WATER MAINS SHALL BE 8" DUCTILE IRON.

COUNTY ALBANY	TIMBER LANE WATER MAIN	STATE NEW YORK
DATE OCT.25,1994		SCALE 1"=50'
REVISION	 TOWN OF BETHLEHEM ENGINEERING DIVISION 445 Delaware Ave. Delmar, New York 12054	DRAWING NO.

woodhill sec. 3