


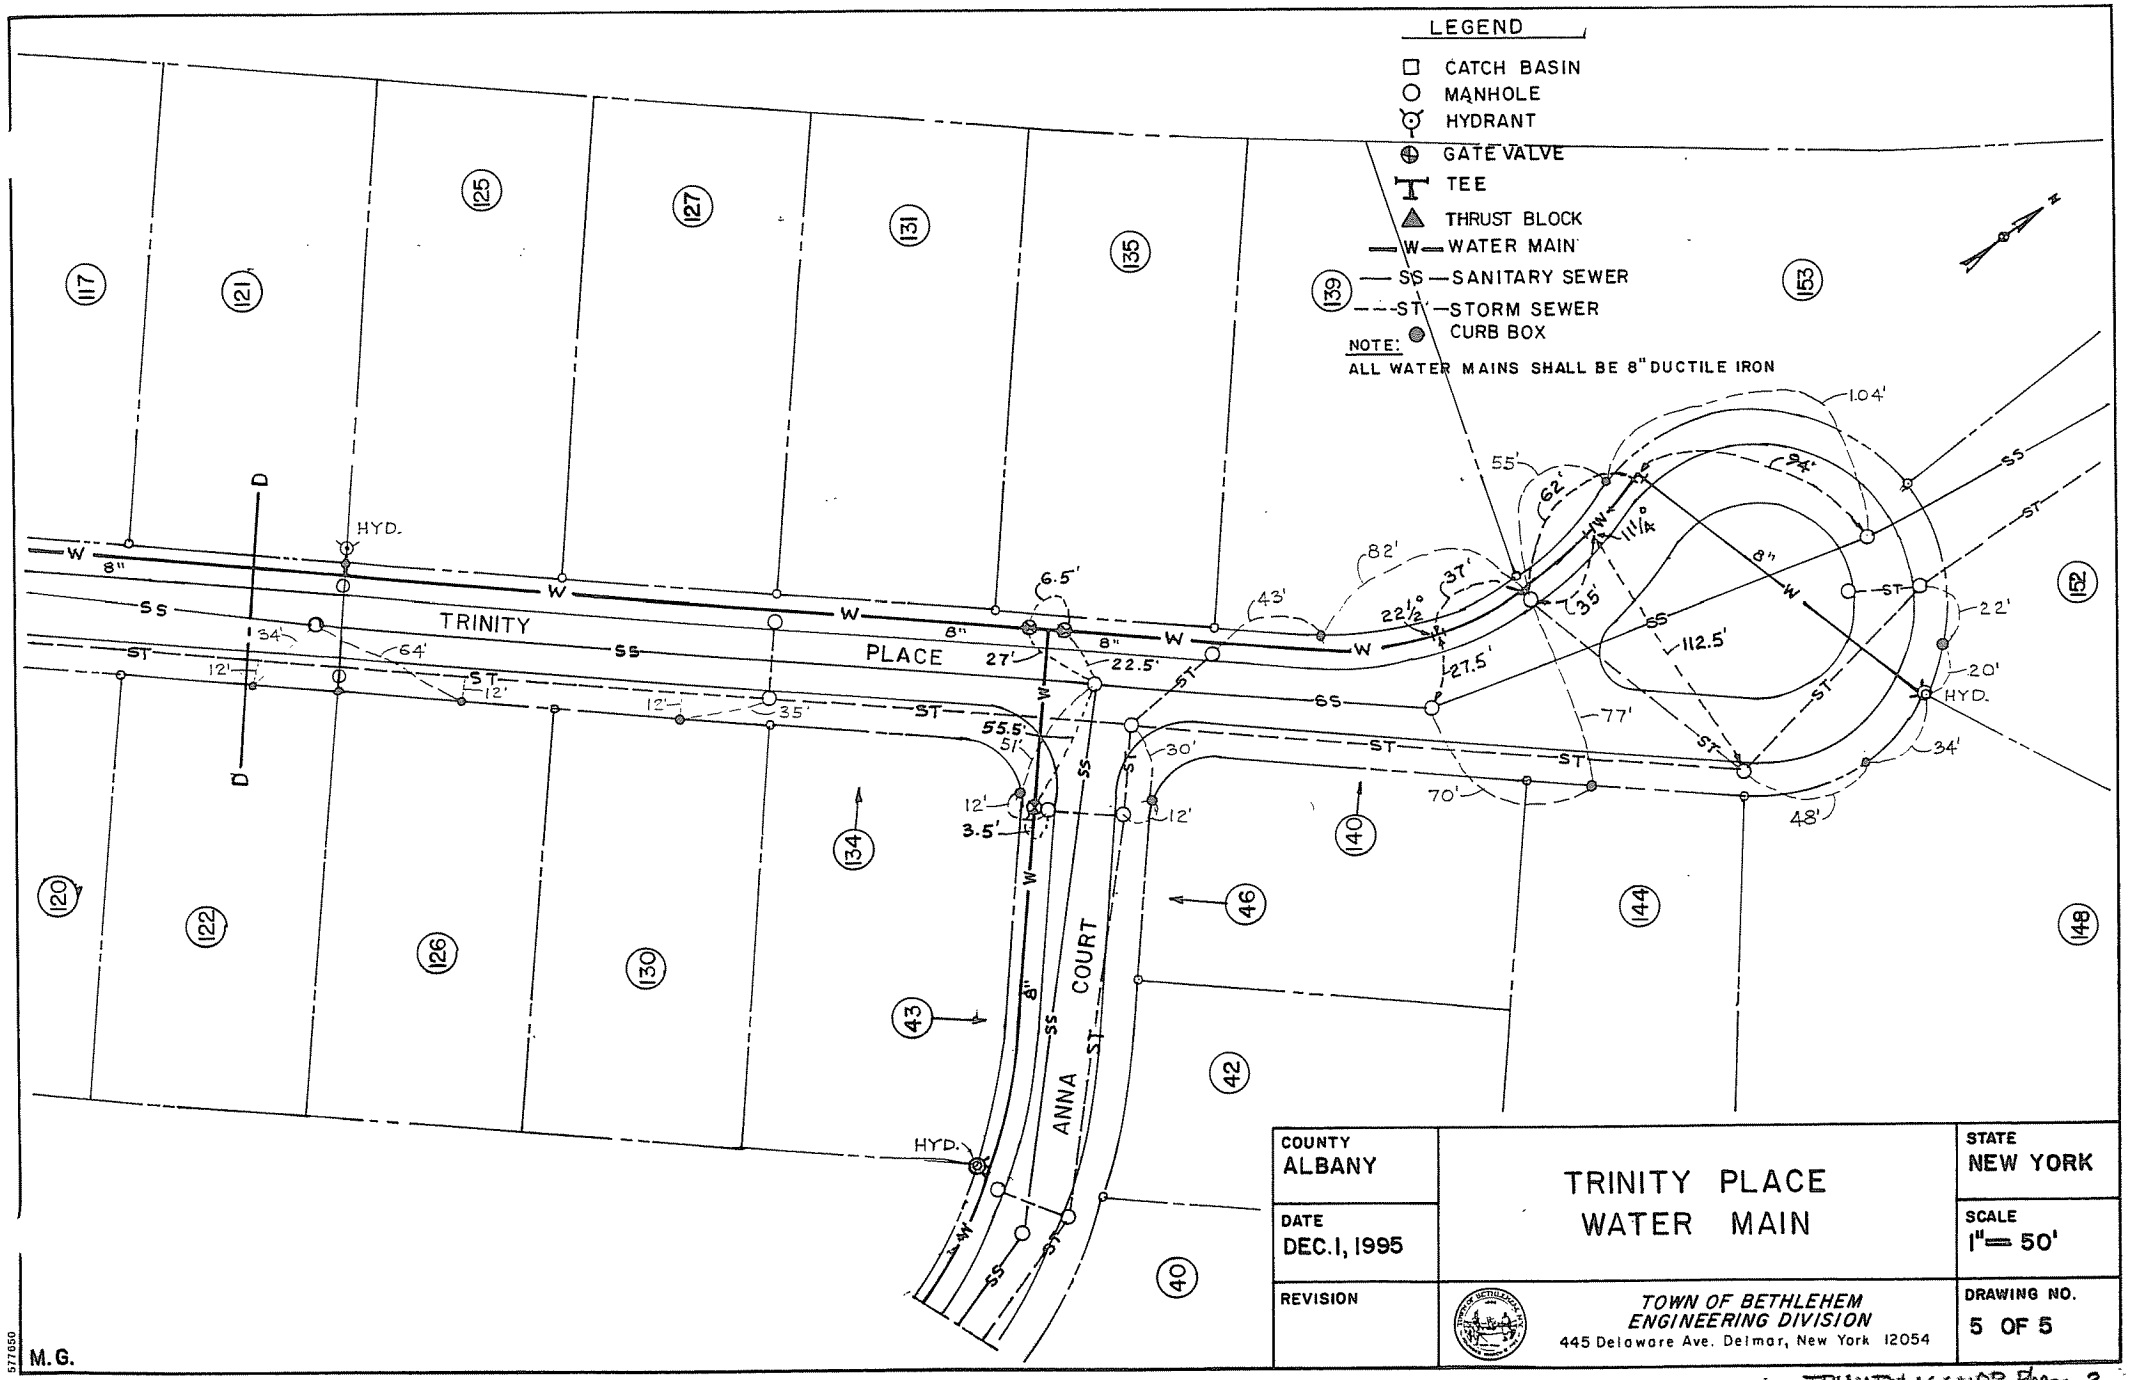

LEGEND

- CATCH BASIN
- MANHOLE
- HYDRANT
- GATE VALVE
- TEE
- THRUST BLOCK
- W - WATER MAIN
- SS - SANITARY SEWER
- ST - STORM SEWER
- CURB BOX

NOTE:
ALL WATER MAINS SHALL BE 8" DUCTILE IRON

COUNTY ALBANY		TRINITY PLACE WATER MAIN	STATE NEW YORK
DATE DEC.1, 1995			SCALE 1"= 50'
REVISION		 TOWN OF BETHLEHEM ENGINEERING DIVISION 445 Delaware Ave. Delmar, New York 12054	DRAWING NO. 5 OF 5