


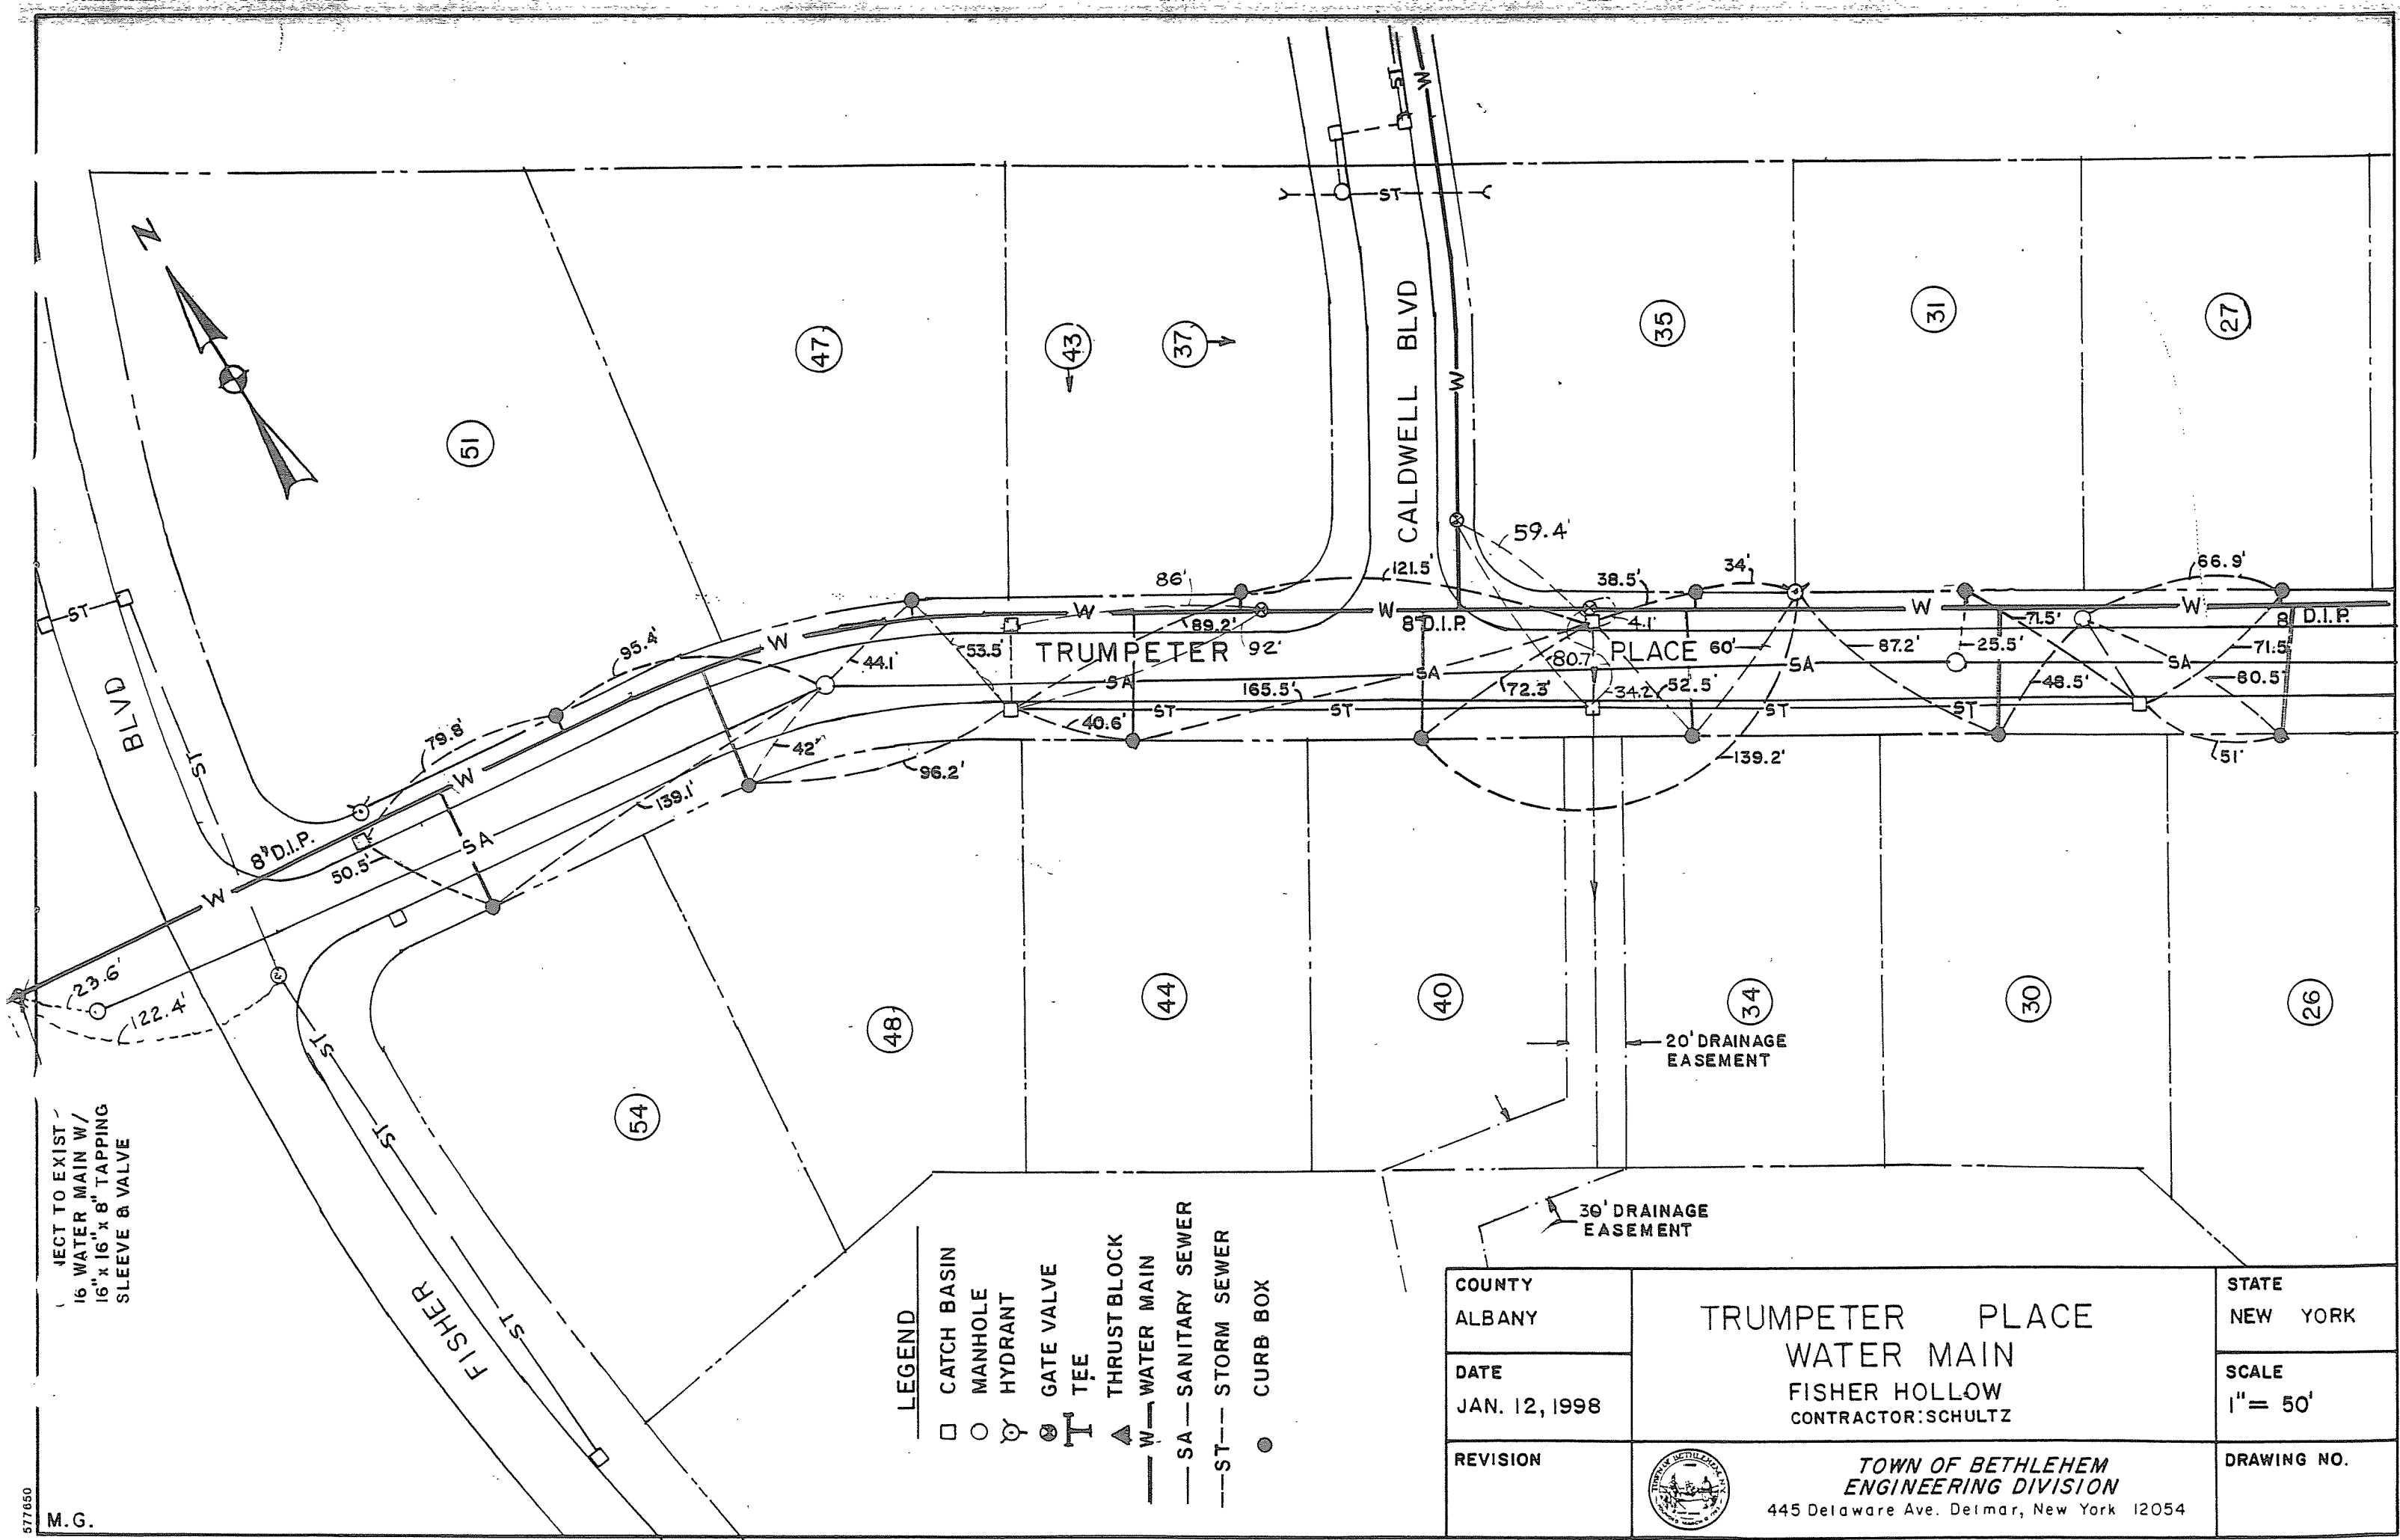

FISHER HOLLOW