




NOTE:

INSTALL 2 FULL LENGTHS OF PIPE AF'1
ON-LINE VALVE FOR FUTURE
CONSTRUCTION CAP WITH
WATERTIGHT PLUG.

Nov. 1993-Original in box
one copy in book
one copy to John.

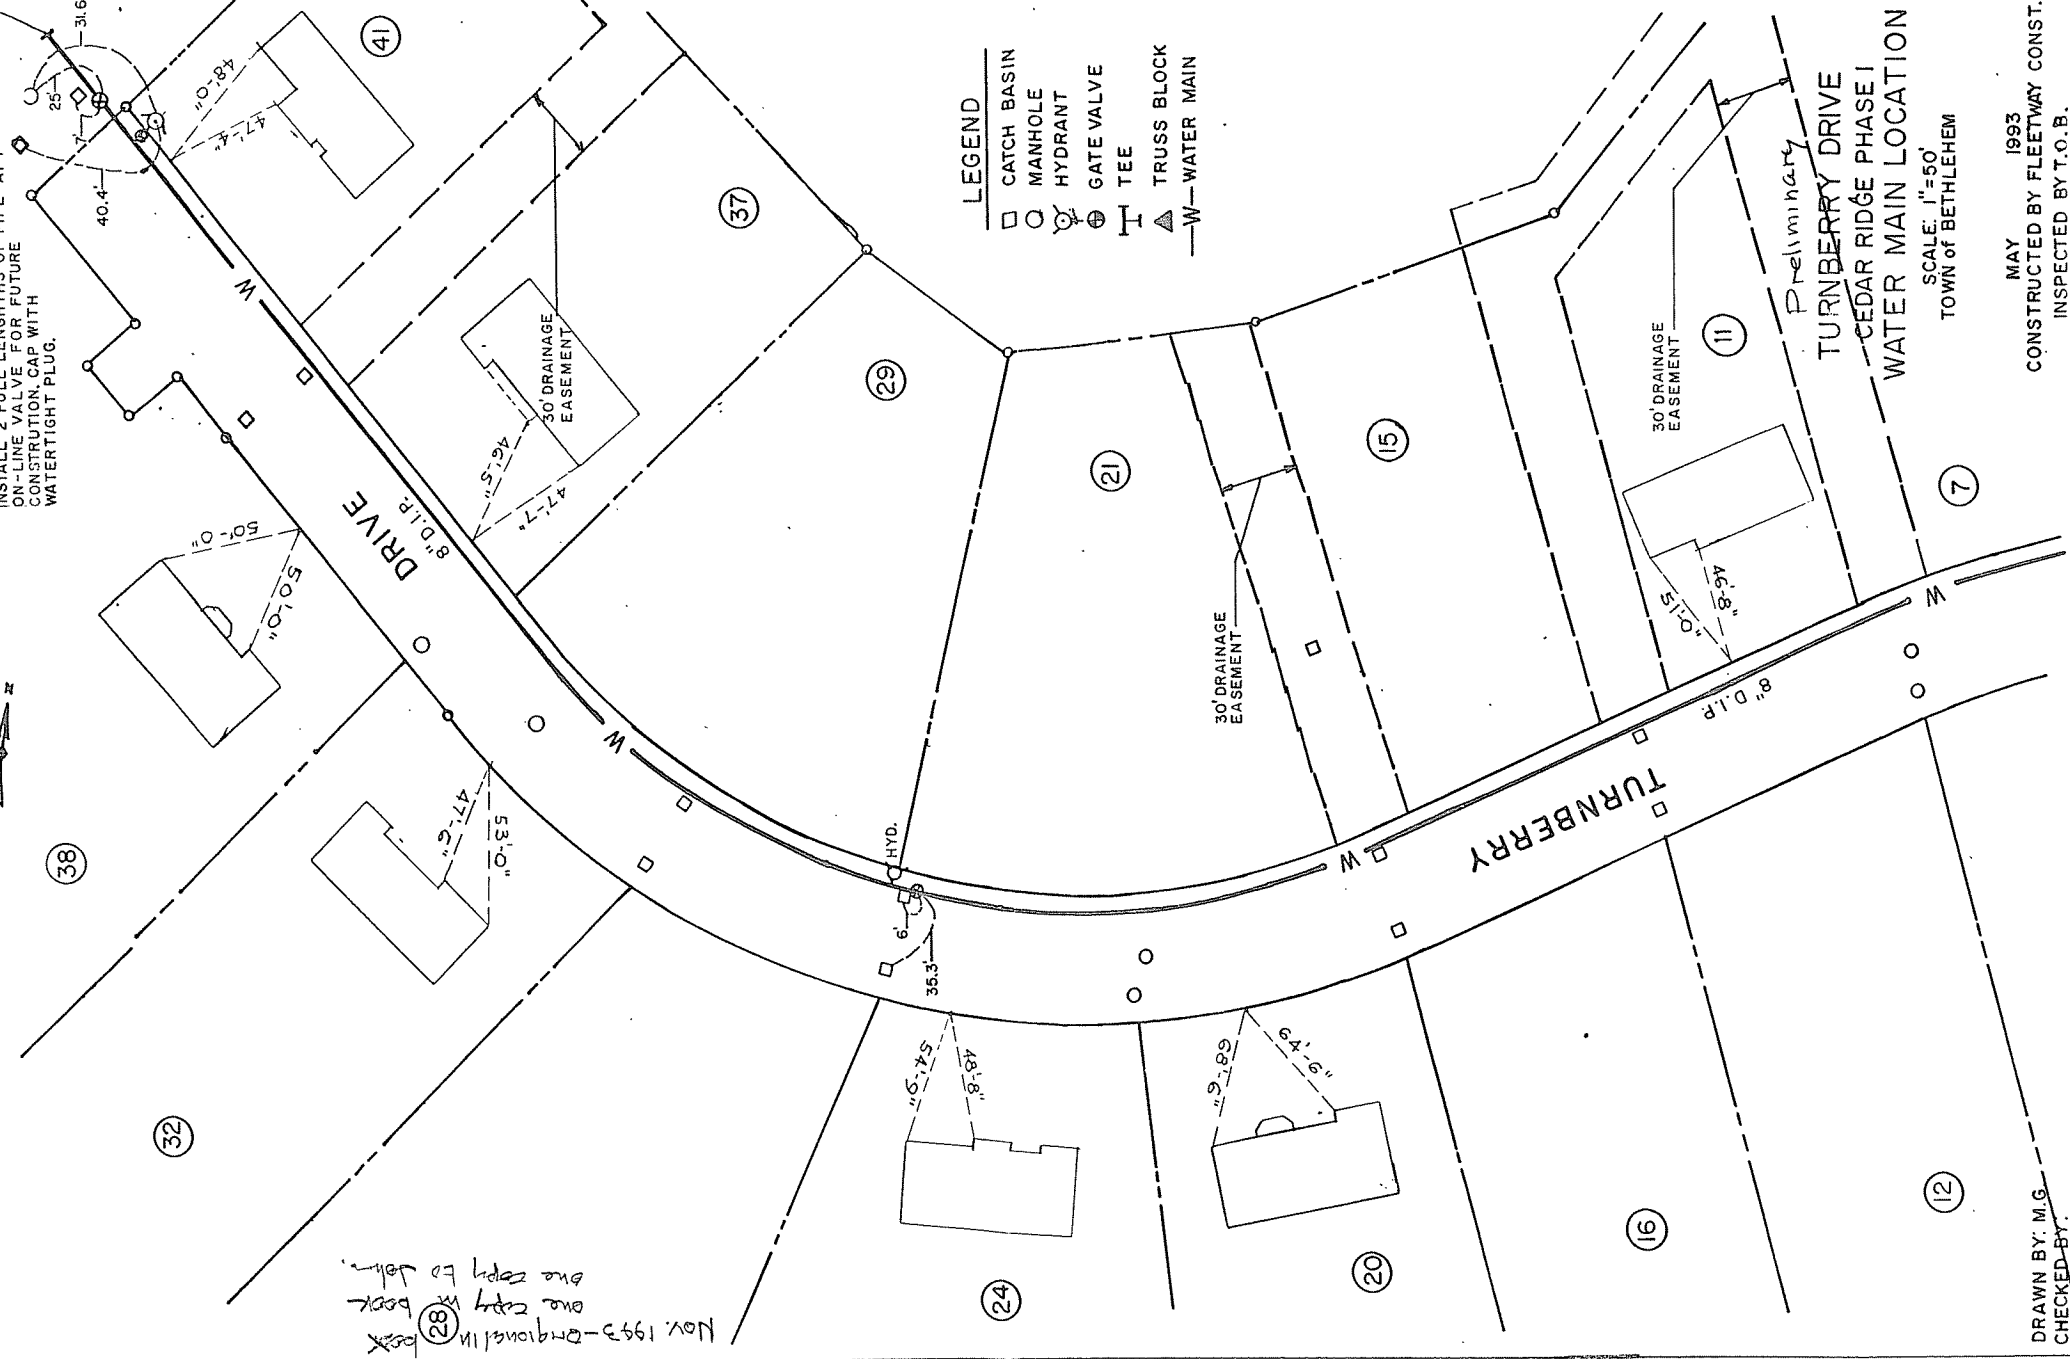

LEGEND

- CATCH BASIN
- MANHOLE
- ⊙ HYDRANT
- ⊕ GATE VALVE
- ⊥ TEE
- ▲ TRUSS BLOCK
- W— WATER MAIN

DRAWN BY: M.G.
CHECKED BY:

MAY 1993
CONSTRUCTED BY FLEETWAY CONST.
INSPECTED BY T.O.B.

SCALE: 1"=50'
TOWN OF BETHLEHEM

TURNBERRY DRIVE
CEDAR RIDGE PHASE I
WATER MAIN LOCATION
Preliminary