


NOTE:

INSTALL 2 1/2" LENGTHS OF PIPE AFTER
ON-LINE VALVE FOR FUTURE
CONSTRUCTION, CAP WITH
WATERTIGHT PLUG.

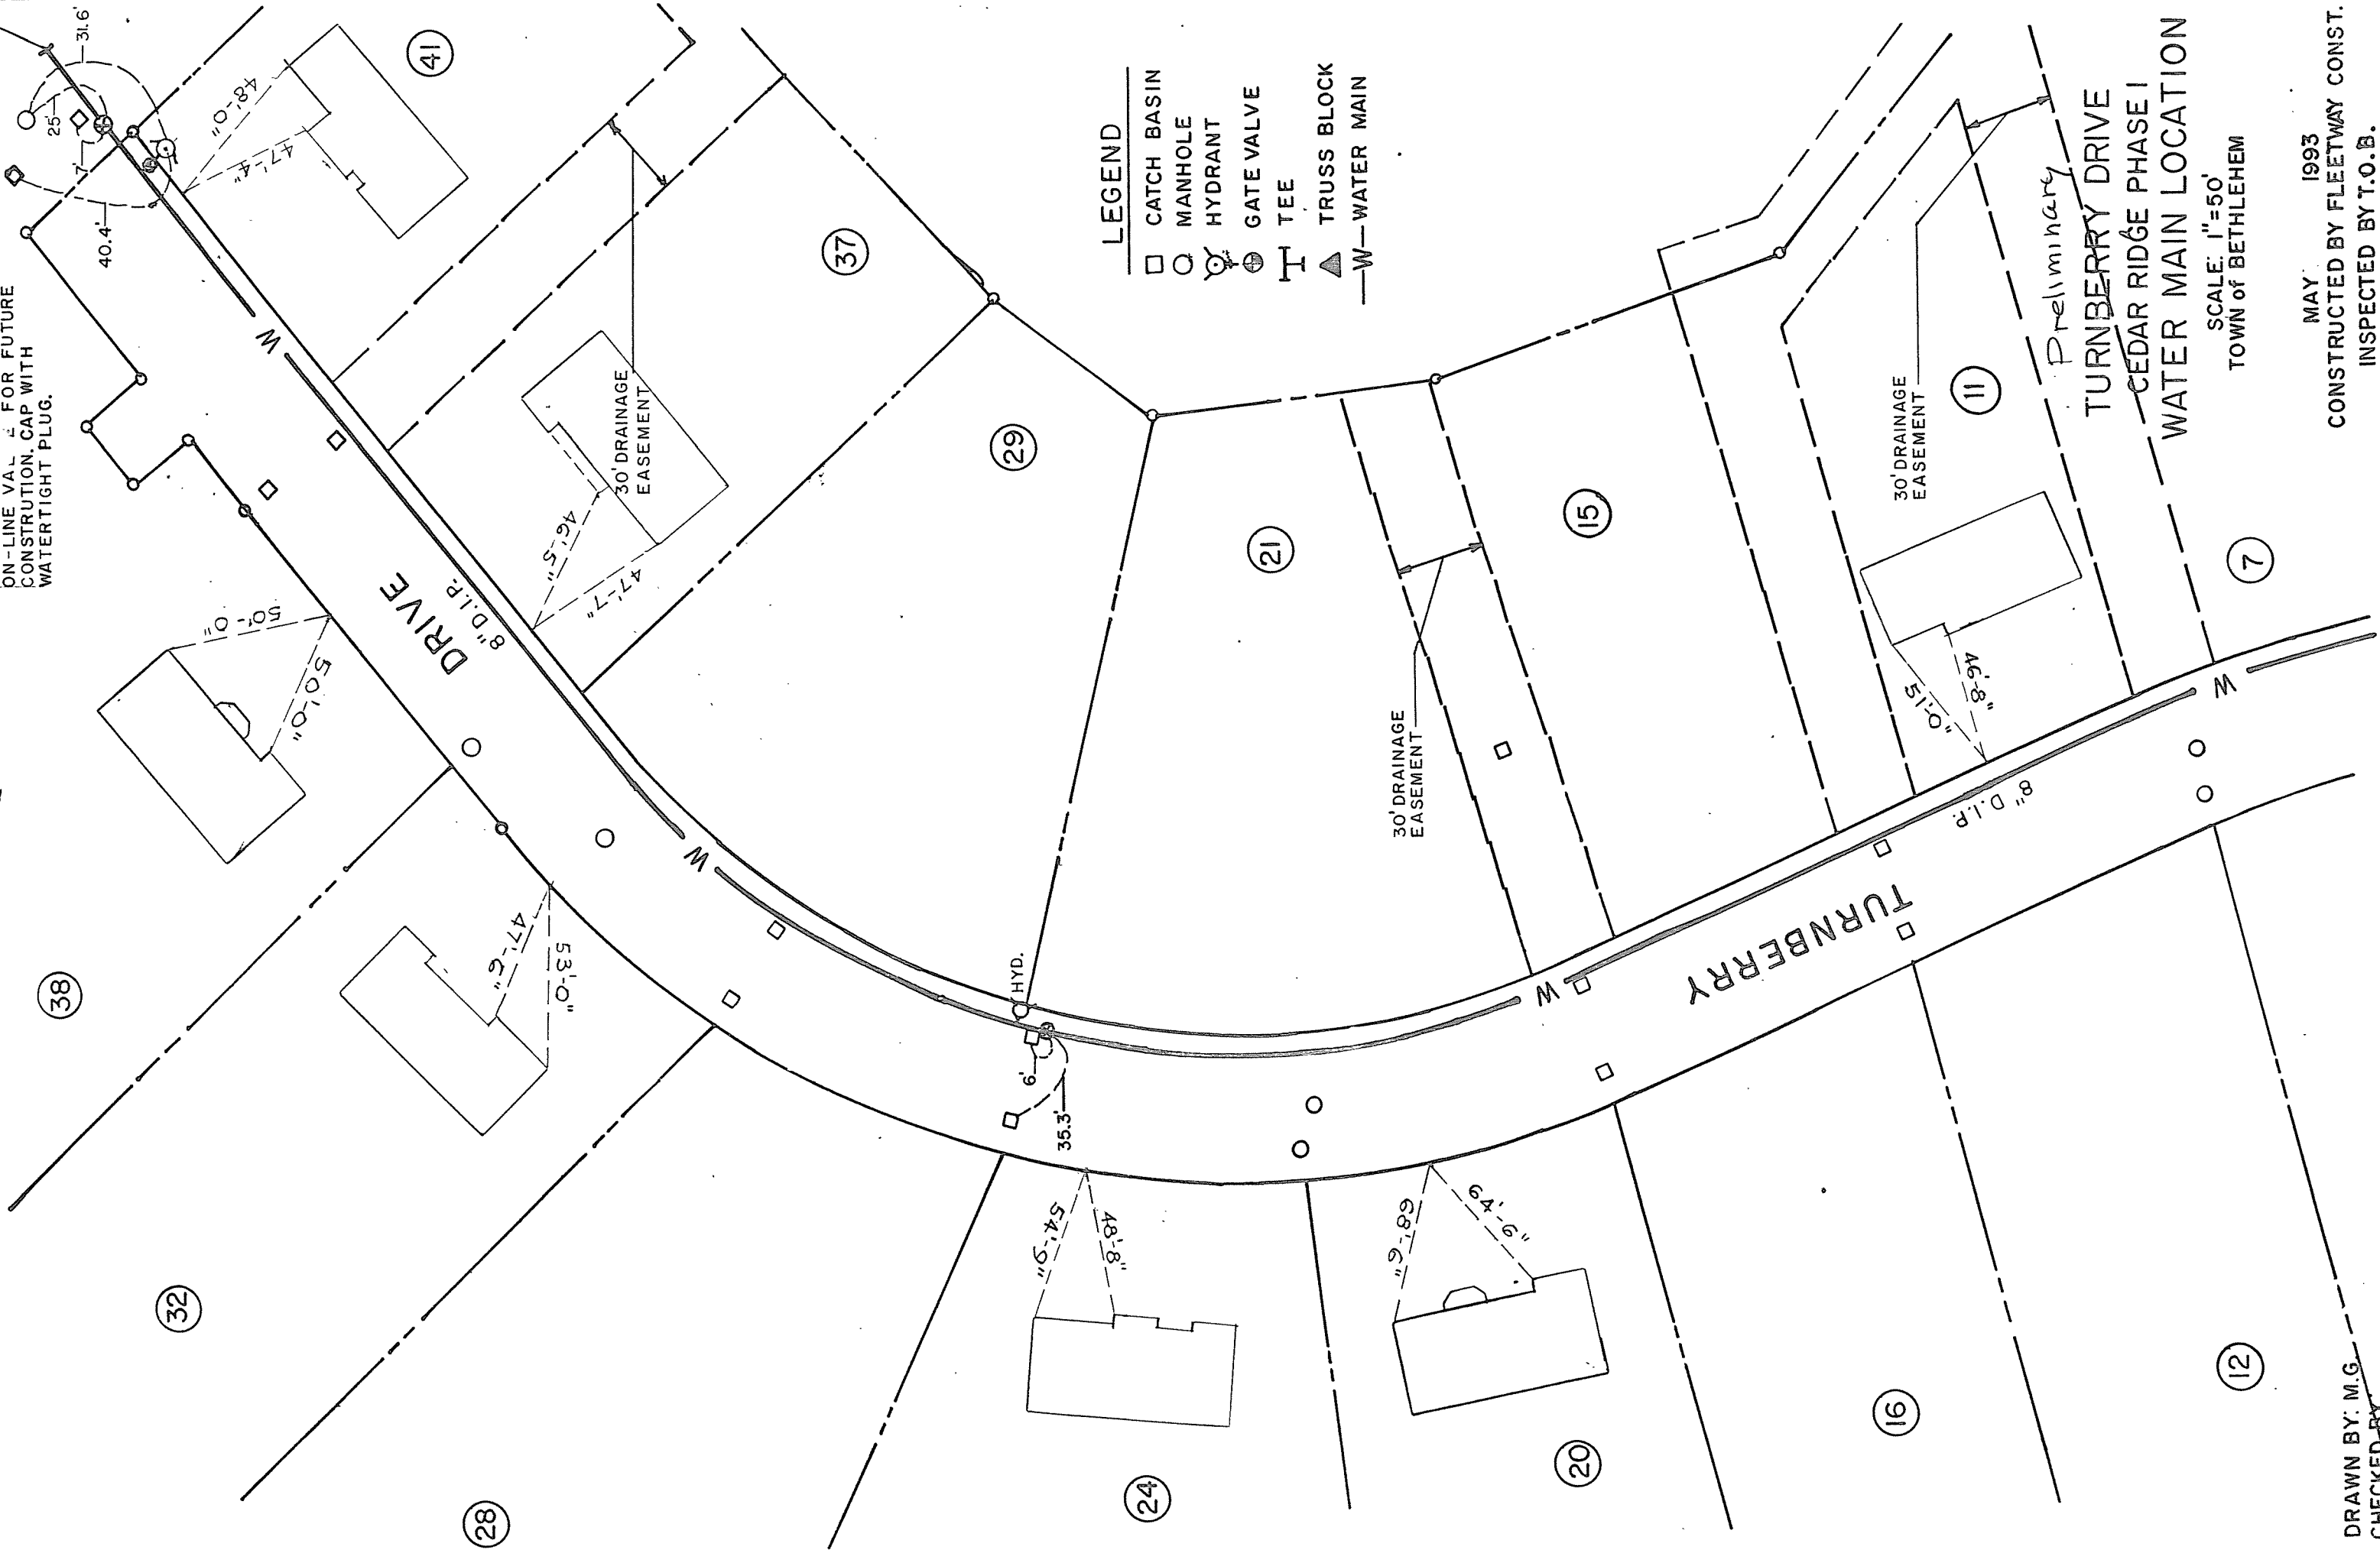

- LEGEND
- CATCH BASIN
 - MANHOLE
 - HYDRANT
 - GATE VALVE
 - TEE
 - TRUSS BLOCK
 - W-WATER MAIN

DRAWN BY: M.G.
CHECKED BY:
MAY 1993
CONSTRUCTED BY FLEETWAY CONST.
INSPECTED BY T.O.B.
TOWN OF BETHLEHEM
CEAR RIDGE PHASE I
TURNBERRY DRIVE
WATER MAIN LOCATION
SCALE: 1"=50'