


LEGEND

PROPERTY LINE
CATCH BASINS
FOR STORM
SEWERS.
SANITARY SEW

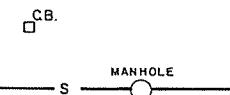

UNION AVENUE SOUTH
WATER DISTRICT NO. 1

TOWN OF BETHLEHEM

RECORD OF INSTALLATIONS

J. KENNETH FRASER & ASSOCIATES, P.C.
CONSULTING ENGRS. RENSSELAER, N.Y.
SCALE 1"=50' AUGUST 1977