


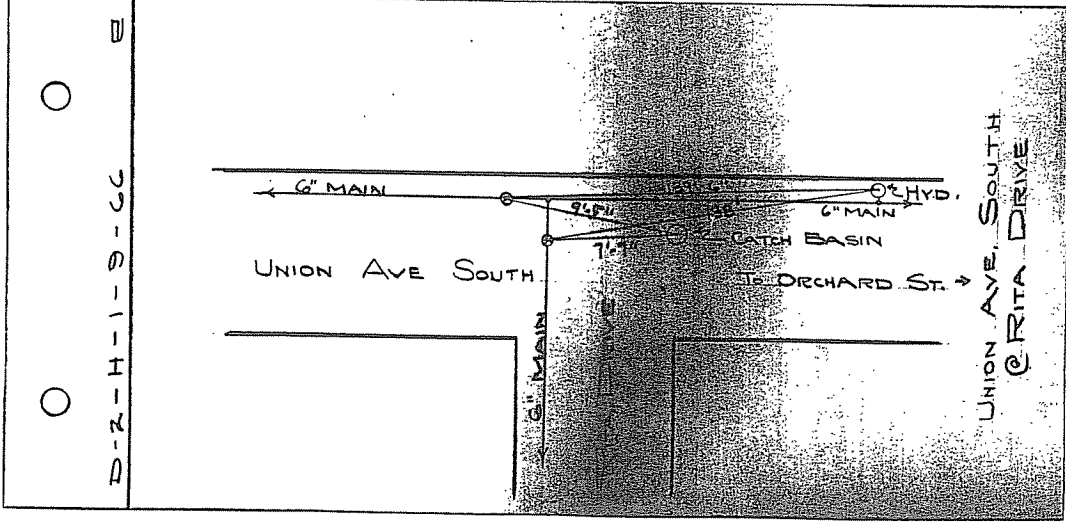

UNION AVE SOUTH
WATER MAIN