
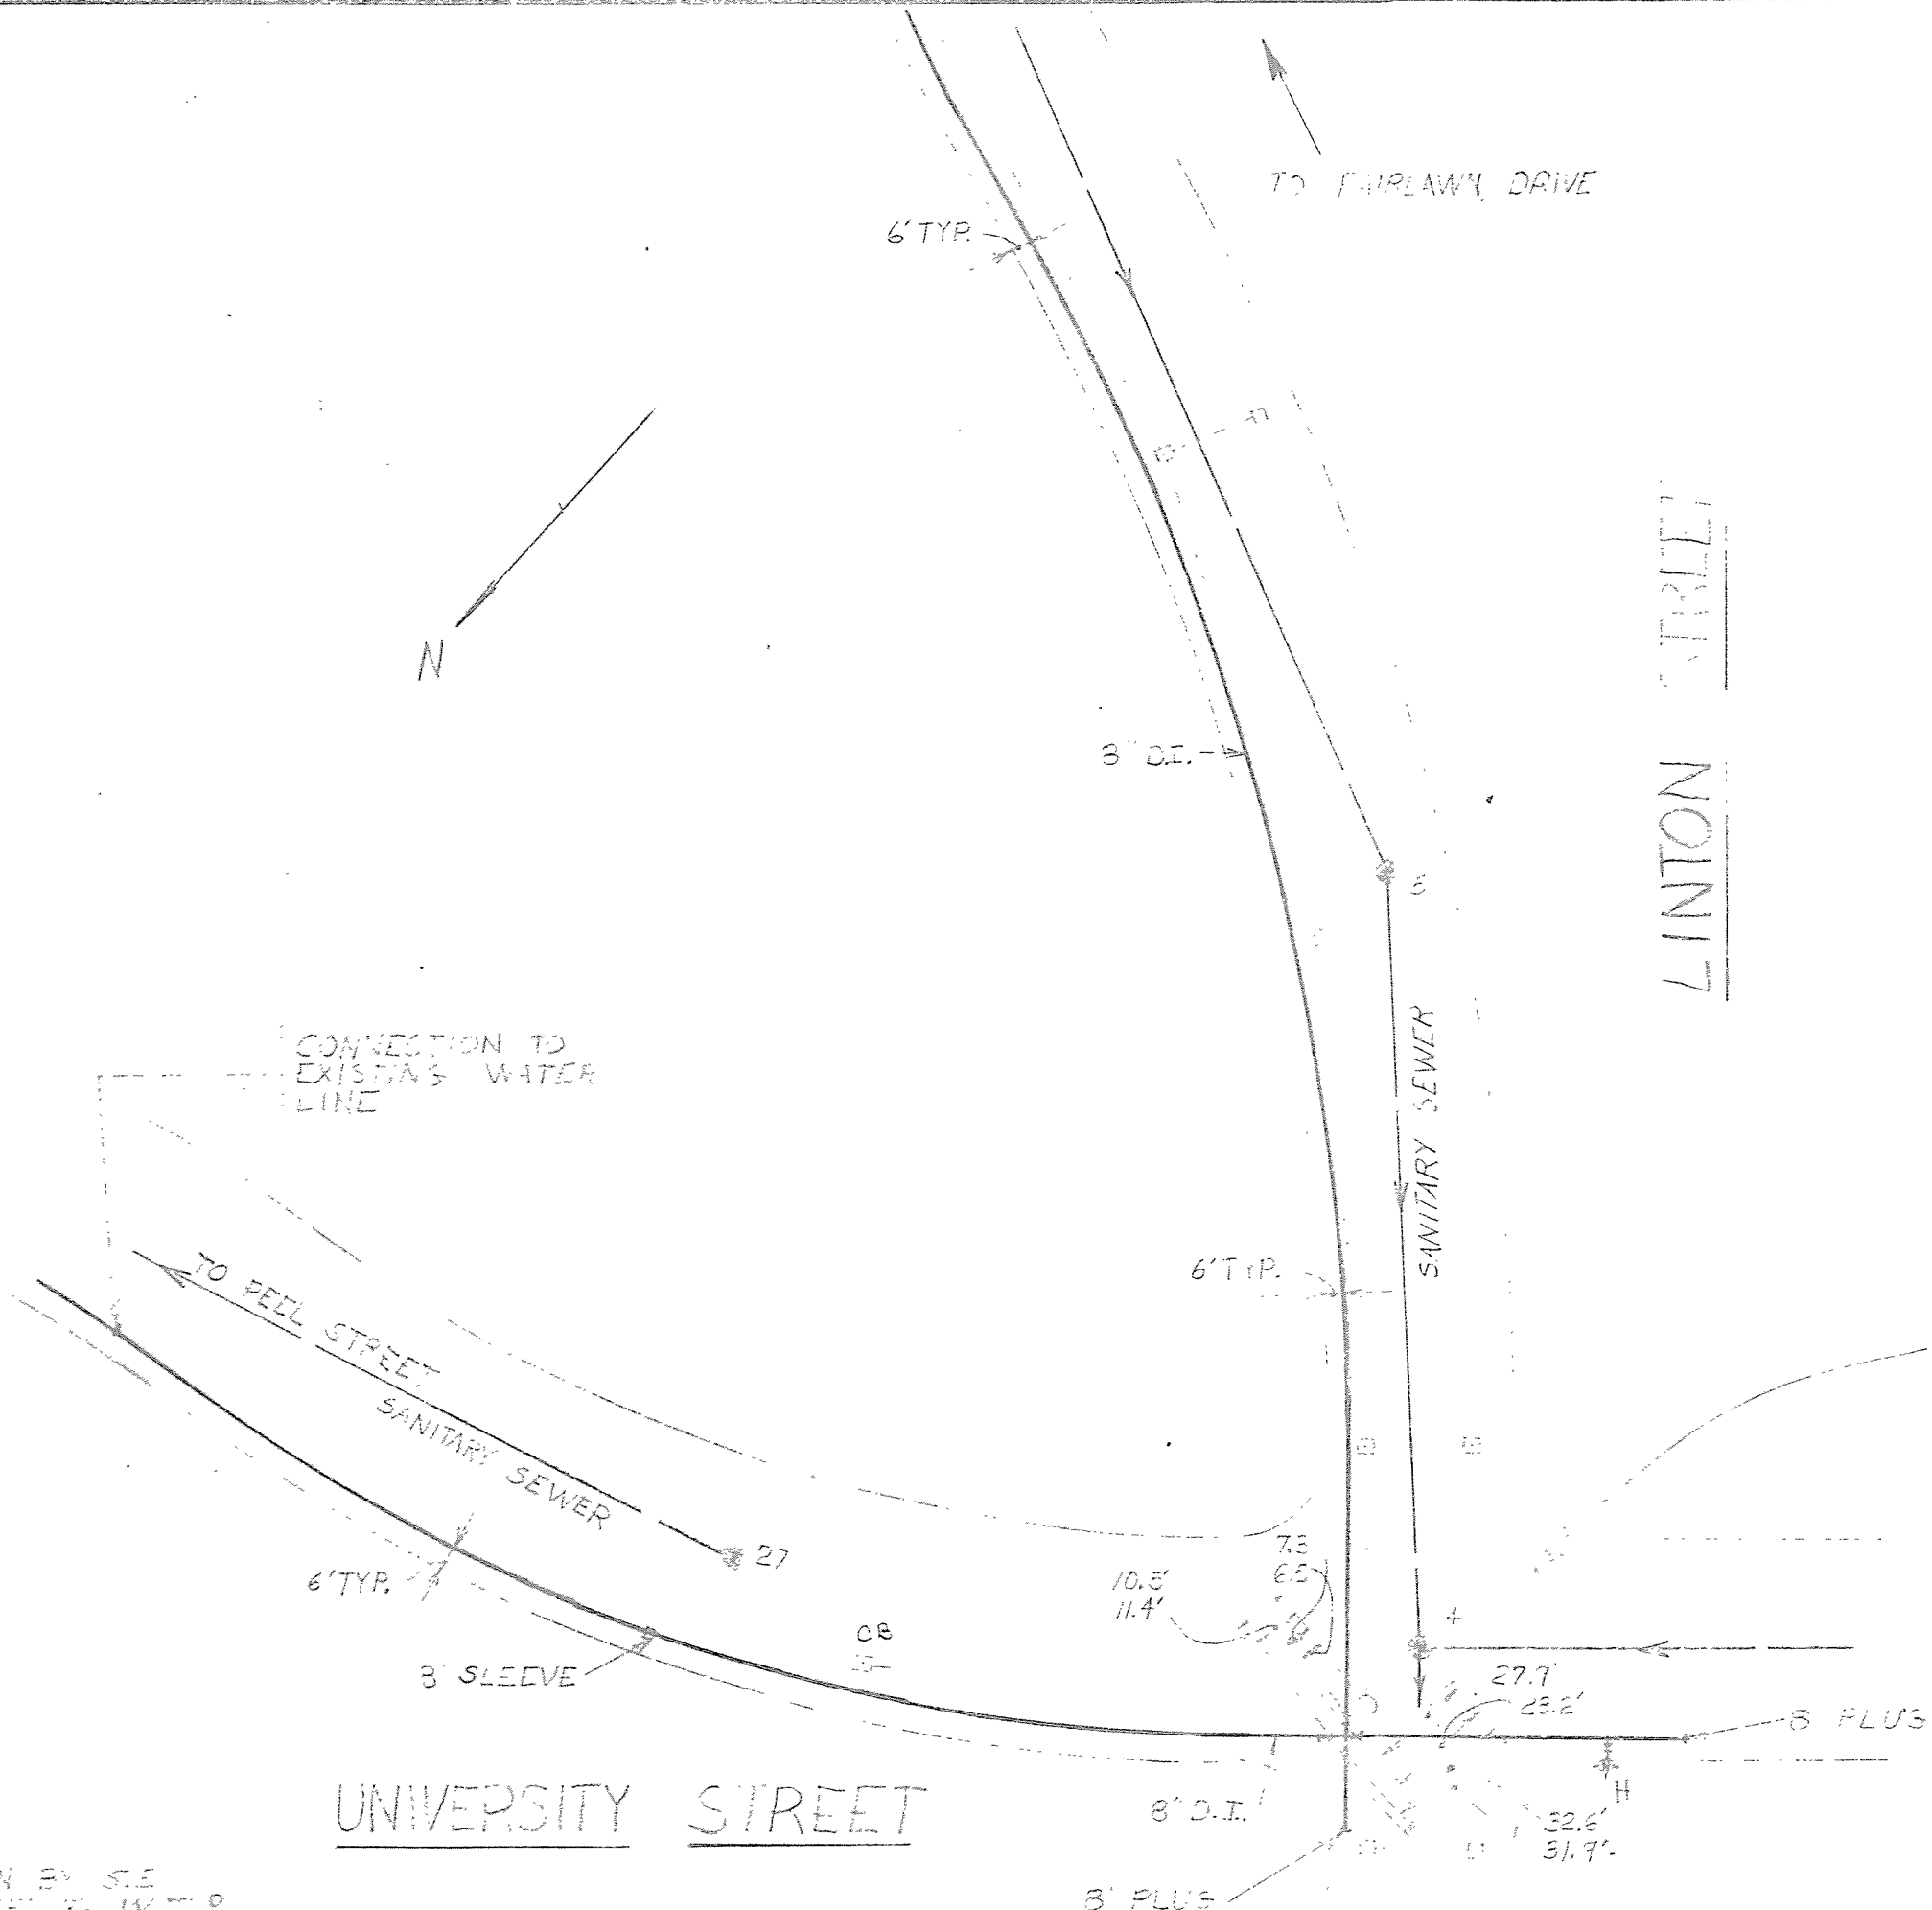
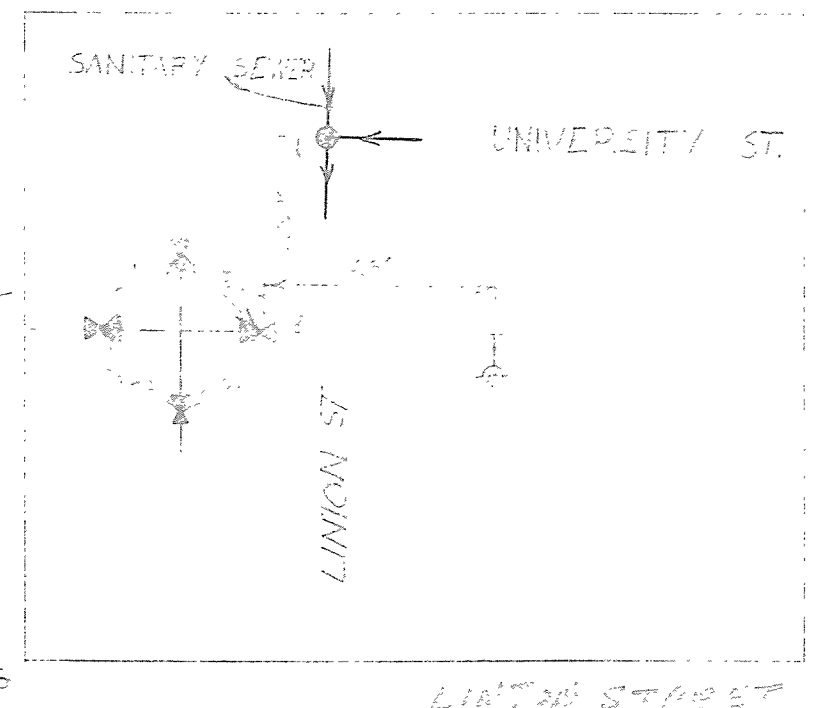


SKYCREST
 WATER DISTRICT NO. 1
 TOWN OF BETHLEHEM
RECORD OF INSTALLATIONS
 J. KENNETH FRASER & ASSOCIATES, P.C.
 CONSULTING ENGRS. RENSSELAER, N.Y.
 SCALE 1"=50' AUGUST 1976

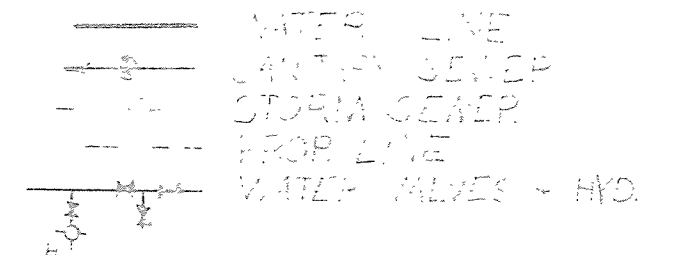

DRAWN BY S.E.
 CHECKED BY W.T.P.
 9.8.76