

UNIVERSITY STREET
WATER DISTRICT NO. 1
TOWN OF BETHLEHEM


RECORD OF INSTALLATION
TOWN OF BETHLEHEM ENGINEERING
DEPARTMENT

SCALE: 1"=50'


NOVEMBER, 1982

DWN. BY: PDH


AVENUE

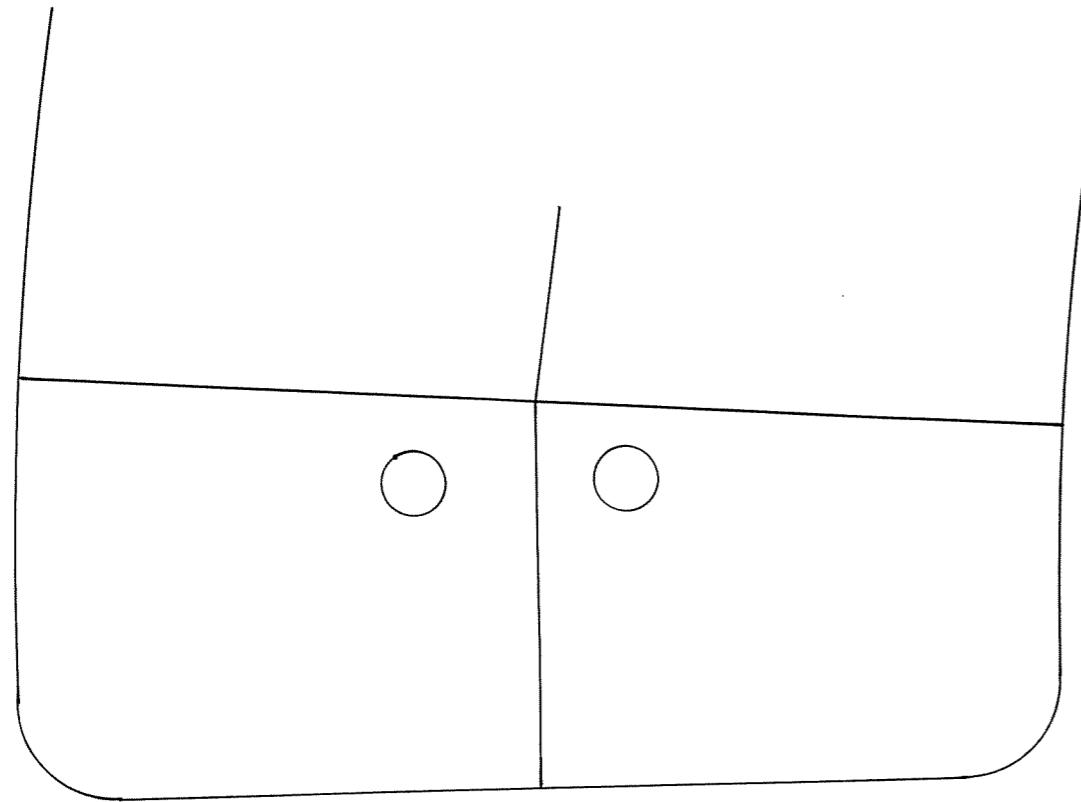

BELLEVUE STREET

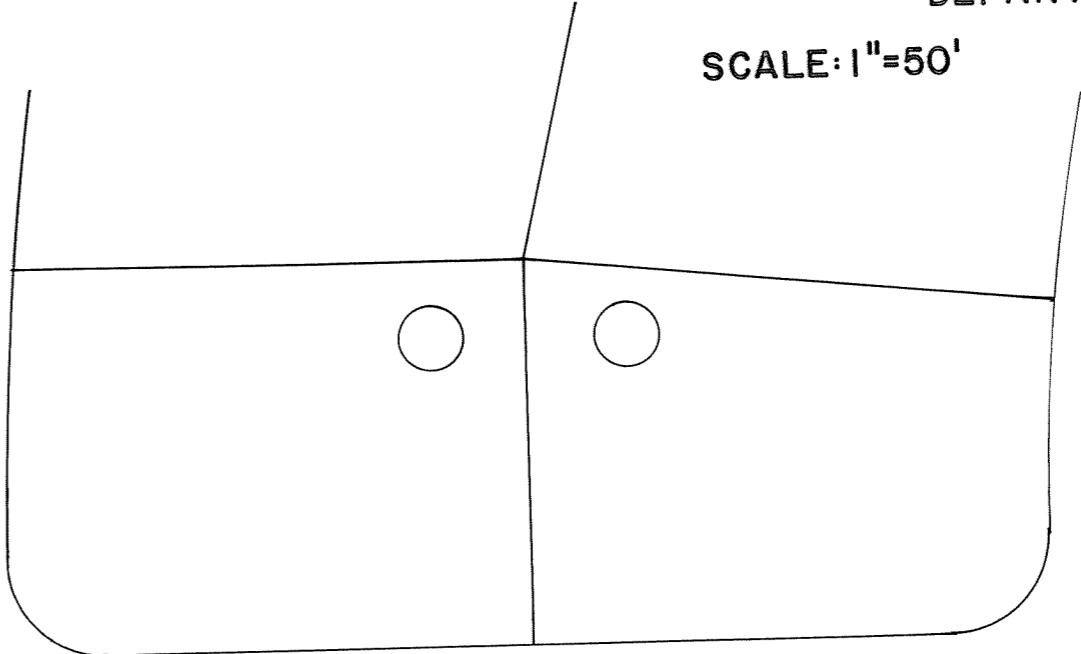

DORCHESTER AVE.

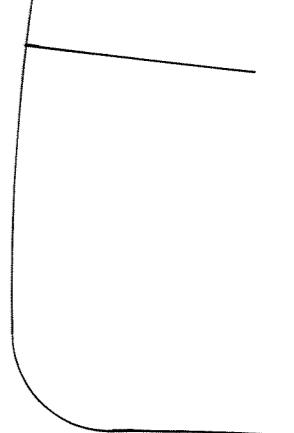

UNIVERSITY

STREET

DORCHESTER

