
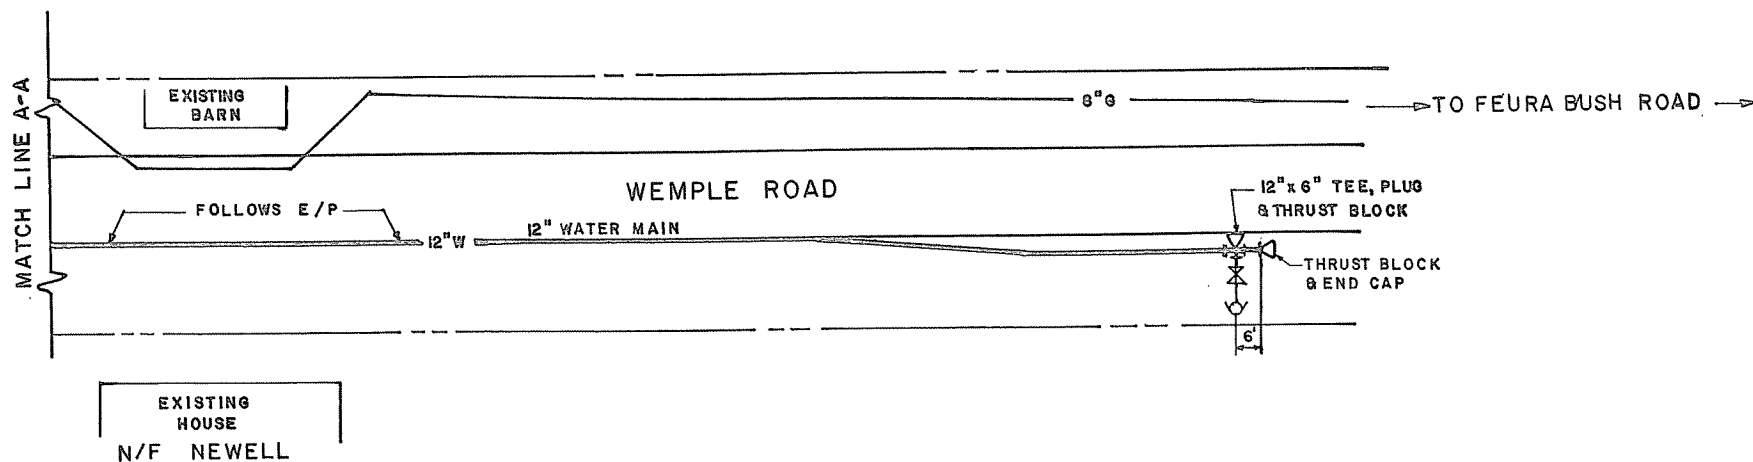


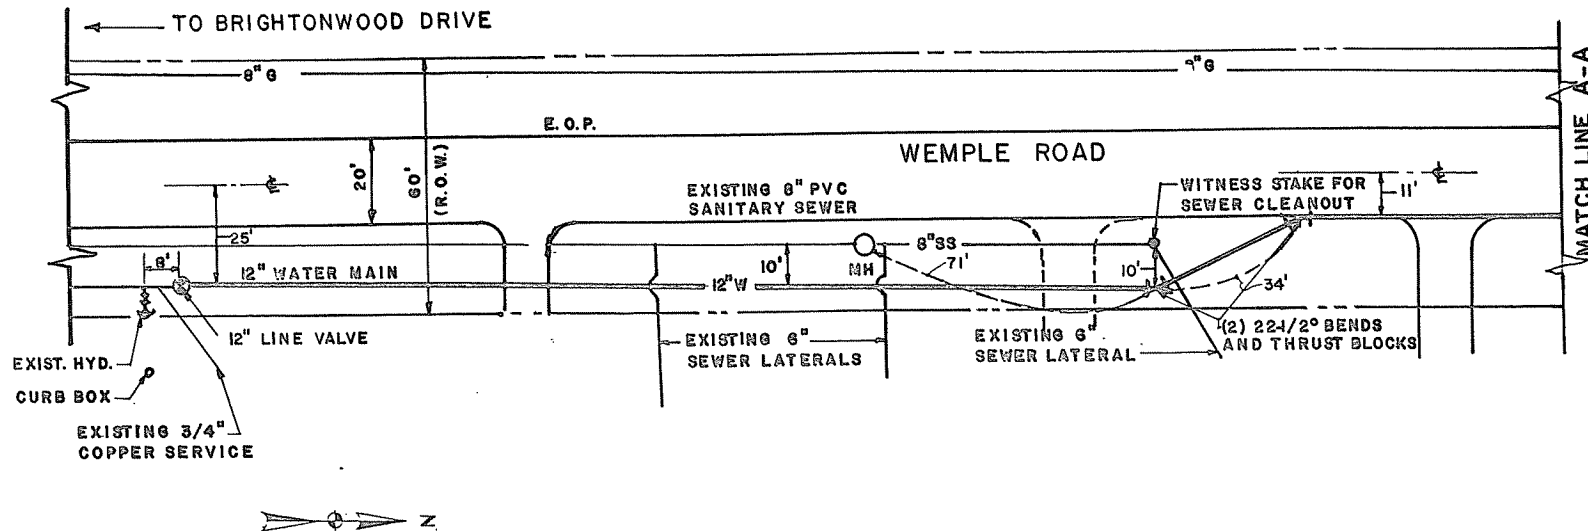

UPPER WEMPLE RD. WATER EXTENSION

DRAWN BY MG.
CHECKED BY DMS.

AUG. 22, 1990
SCALE: 1" = 30'

RECORD
DRAWING