
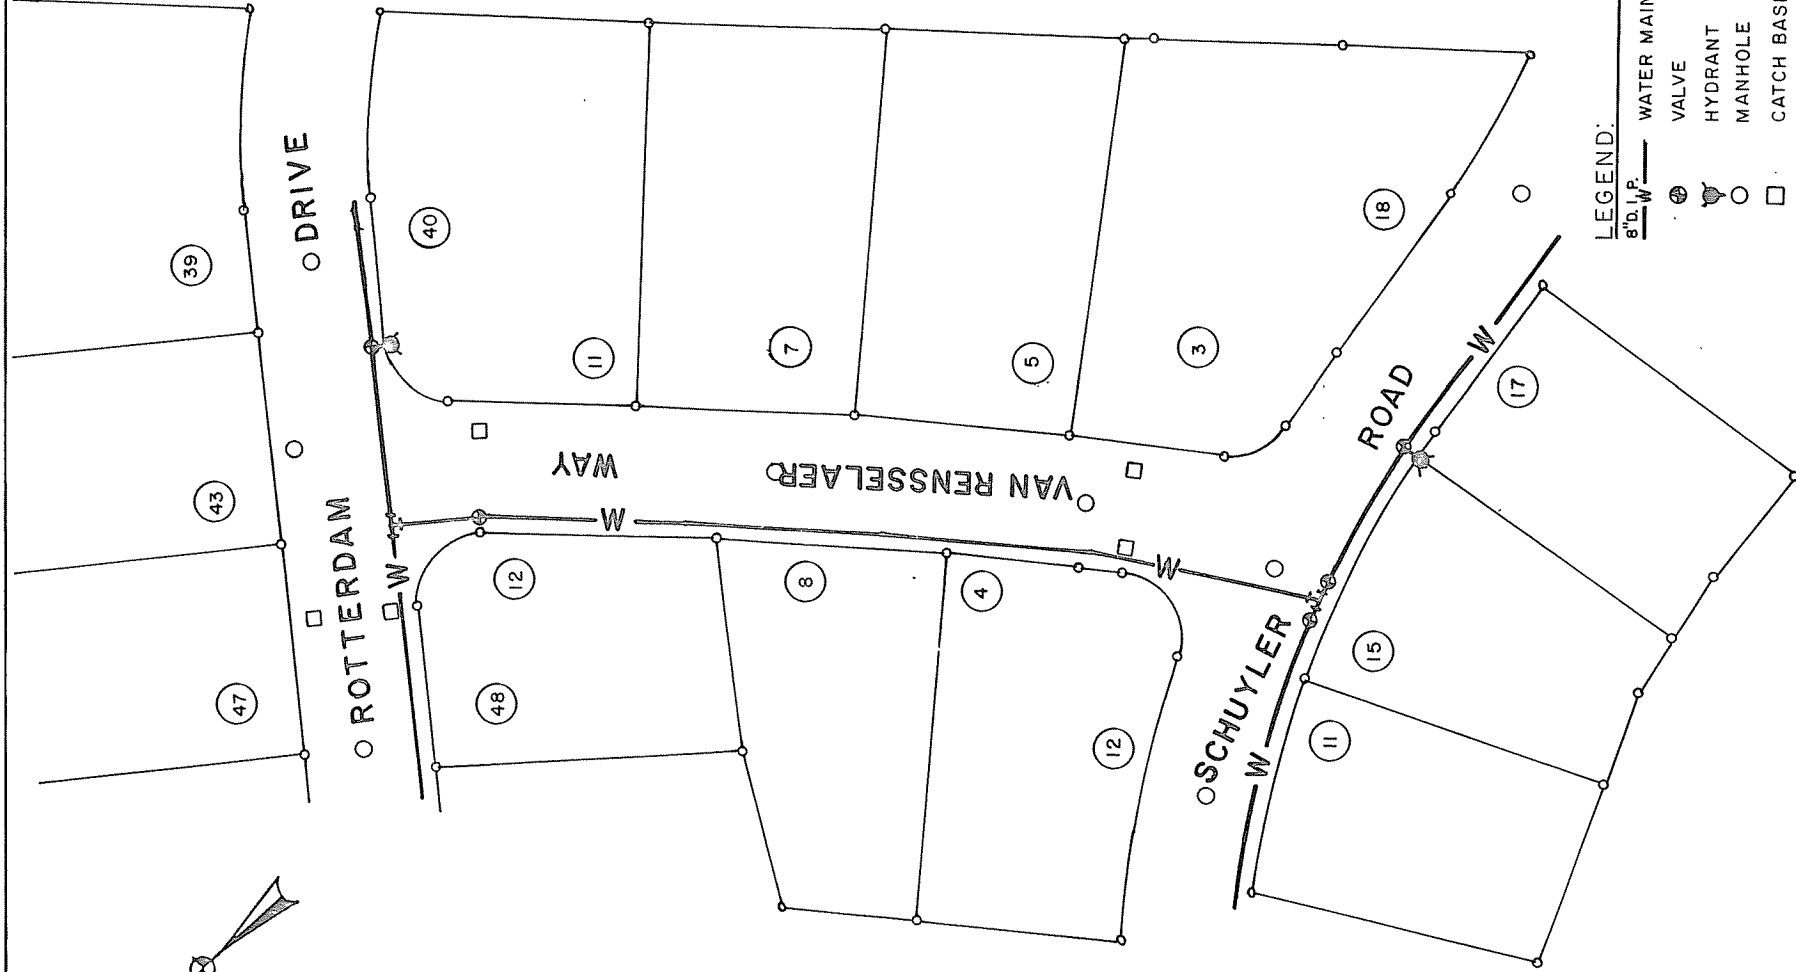


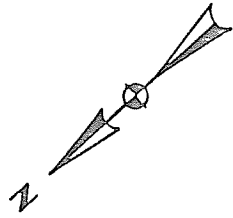

LEGEND:
8" D. W.P. — WATER MAIN
● VALVE
⦿ HYDRANT
○ MANHOLE
□ CATCH BASIN

DRAFT

VAN RENSSELAER WAY
WATER MAIN

APRIL 1992 RECORD
SCALE: 1" = 50' DRAWING
BY TRINITY CONSTRUCTION
DRAWN BY M.G.
CHECKED BY D.M.S.