


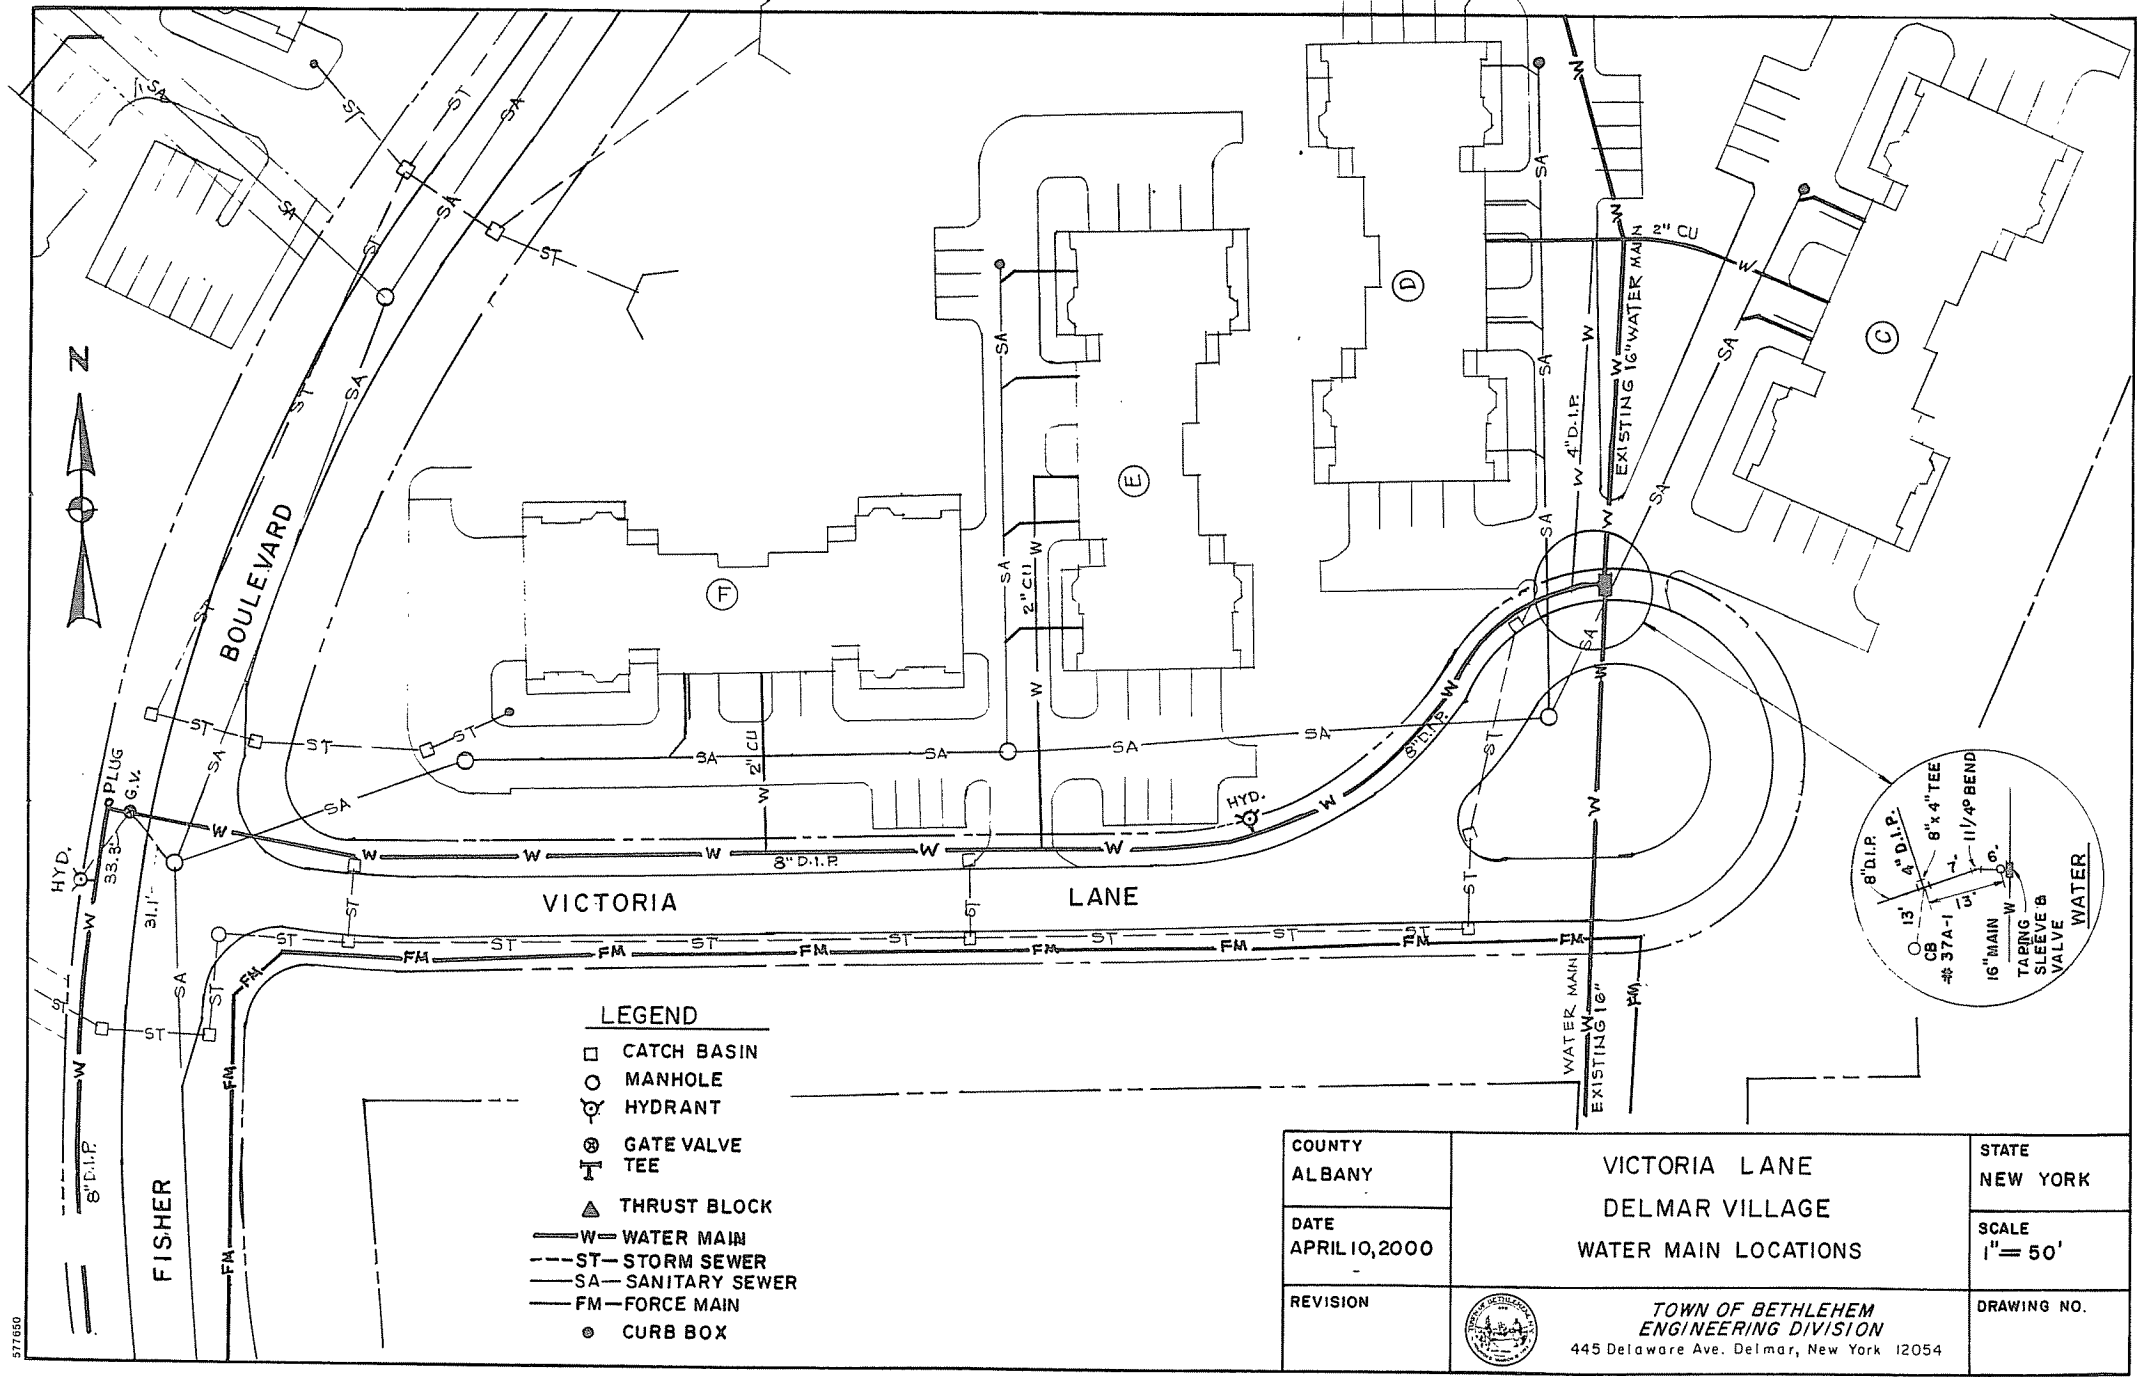

LEGEND

- CATCH BASIN
- MANHOLE
- ⊙ HYDRANT
- ⊕ GATE VALVE
- ⊥ TEE
- ▲ THRUST BLOCK
- W — WATER MAIN
- - - ST — STORM SEWER
- ... SA — SANITARY SEWER
- - - FM — FORCE MAIN
- CURB BOX

COUNTY
ALBANY

DATE
APRIL 10, 2000

REVISION

VICTORIA LANE
DELMAR VILLAGE
WATER MAIN LOCATIONS



TOWN OF BETHLEHEM
ENGINEERING DIVISION
445 Delaware Ave. Delmar, New York 12054

STATE
NEW YORK

SCALE
1" = 50'

DRAWING NO.