


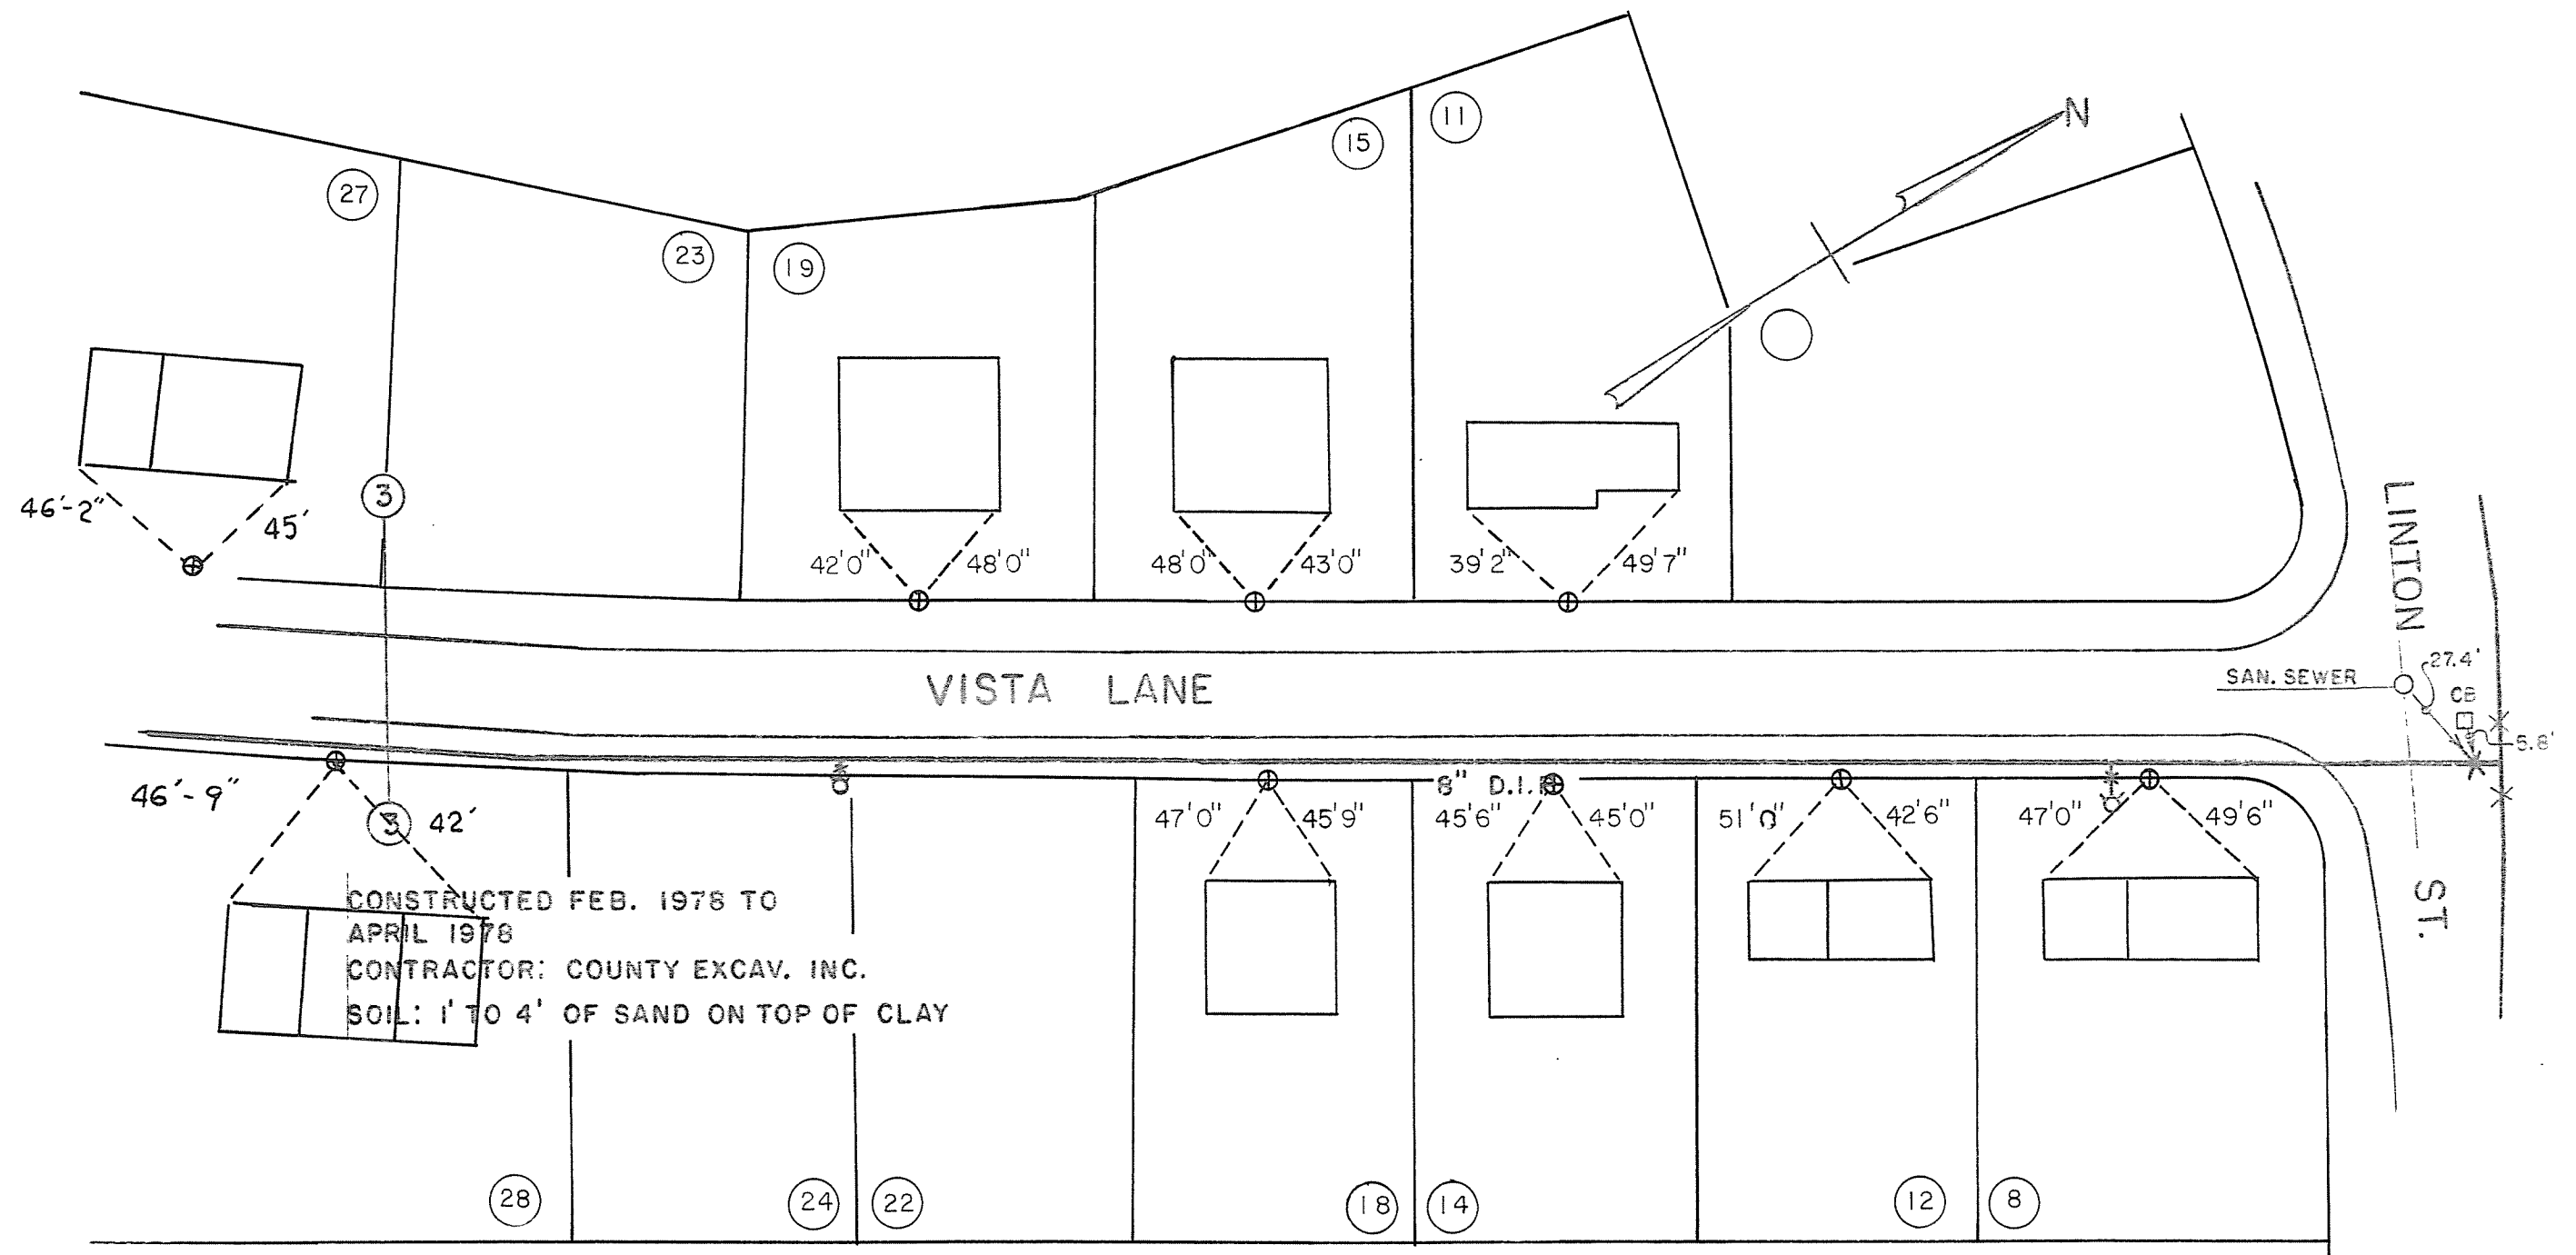

DRAWN BY: H.P.J.
CHECKED BY: W.T.B.