


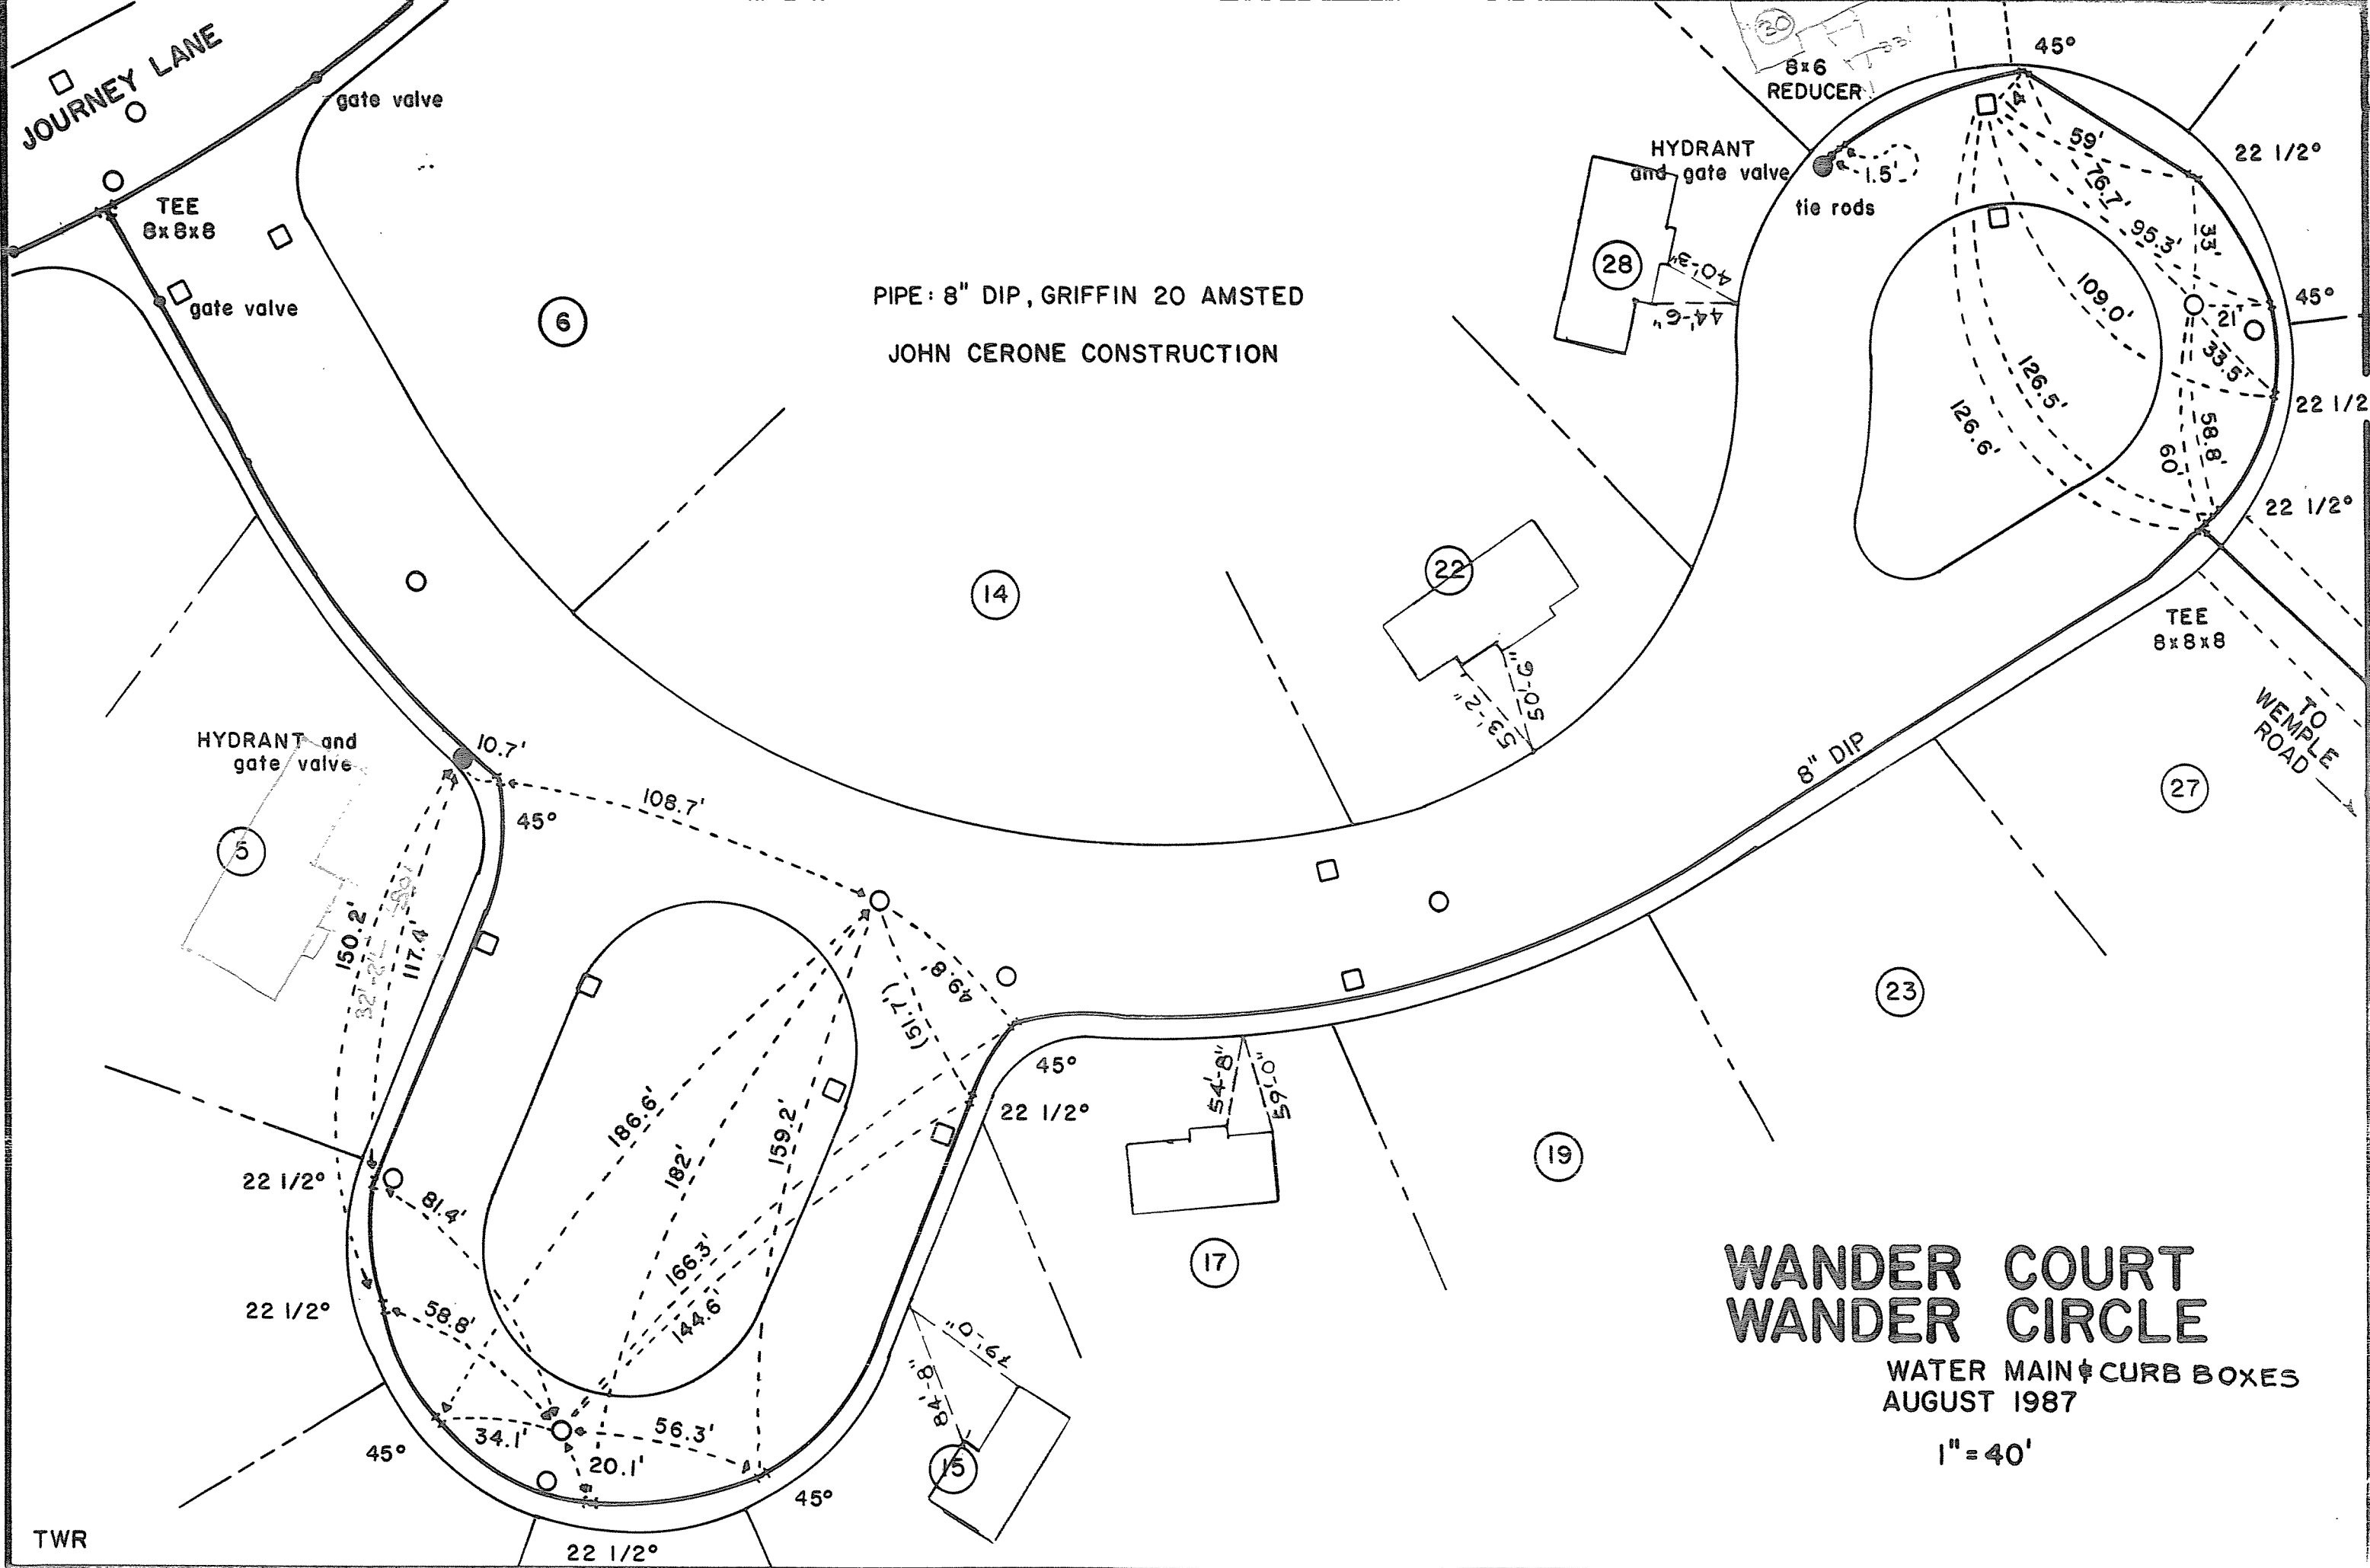

**WANDER COURT
WANDER CIRCLE**
WATER MAIN & CURB BOXES
AUGUST 1987
1" = 40'