



WATER MAIN
INSTALLATION
LYNDHURST

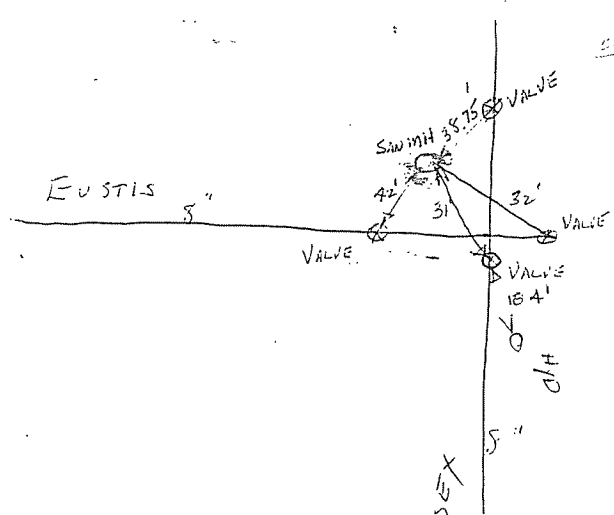

HIDDEL SEX

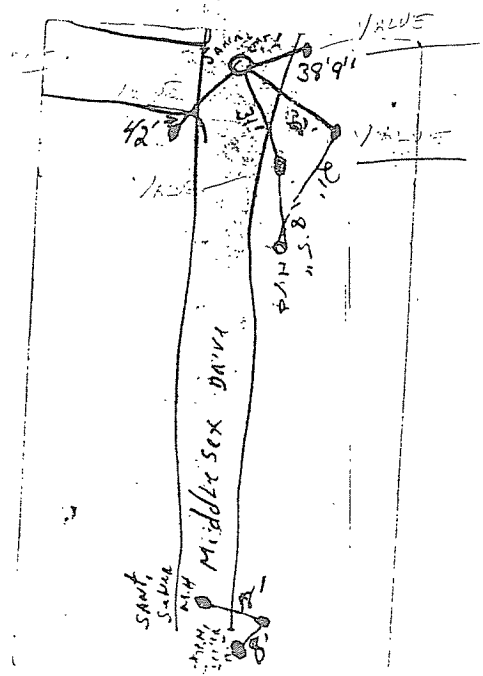

See? address find
Sheet