

WAYNE PLACE

WATER DISTRICT NO. 1

TOWN OF BUTTE

RECORD OF DEEDS

TOWN OF BUTTE

SCALE 1"=50'

NOV 1886

ROAD

ST. CLAIR


540

536

532

530

526

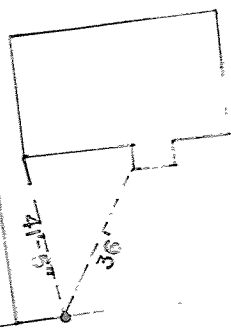

WAYNE

PLACE

CARSON

DRIFT

539

535

533

531

529

