


WEMBLY COURT WEDGEWOOD DRIVE

WATER MAIN LOCATIONS
SCALE 1" = 50'
AUGUST 22, 1989
TRINITY CONST.



NOTE: ALL FITTINGS ARE
22 1/2" 8" D.I.
WITH THRUST BLOCKS

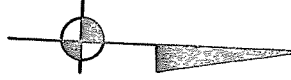