



WELLINGTON ROAD
 WATER DISTRICT NO. 1
 TOWN OF BETHLEHEM
RECORD OF INSTALLATION
 TOWN OF BETHLEHEM ENGINEERING
 DEPARTMENT
 SCALE: 1" = 50' FEBRUARY, 1982
 DWN. BY: PDH

PLACE

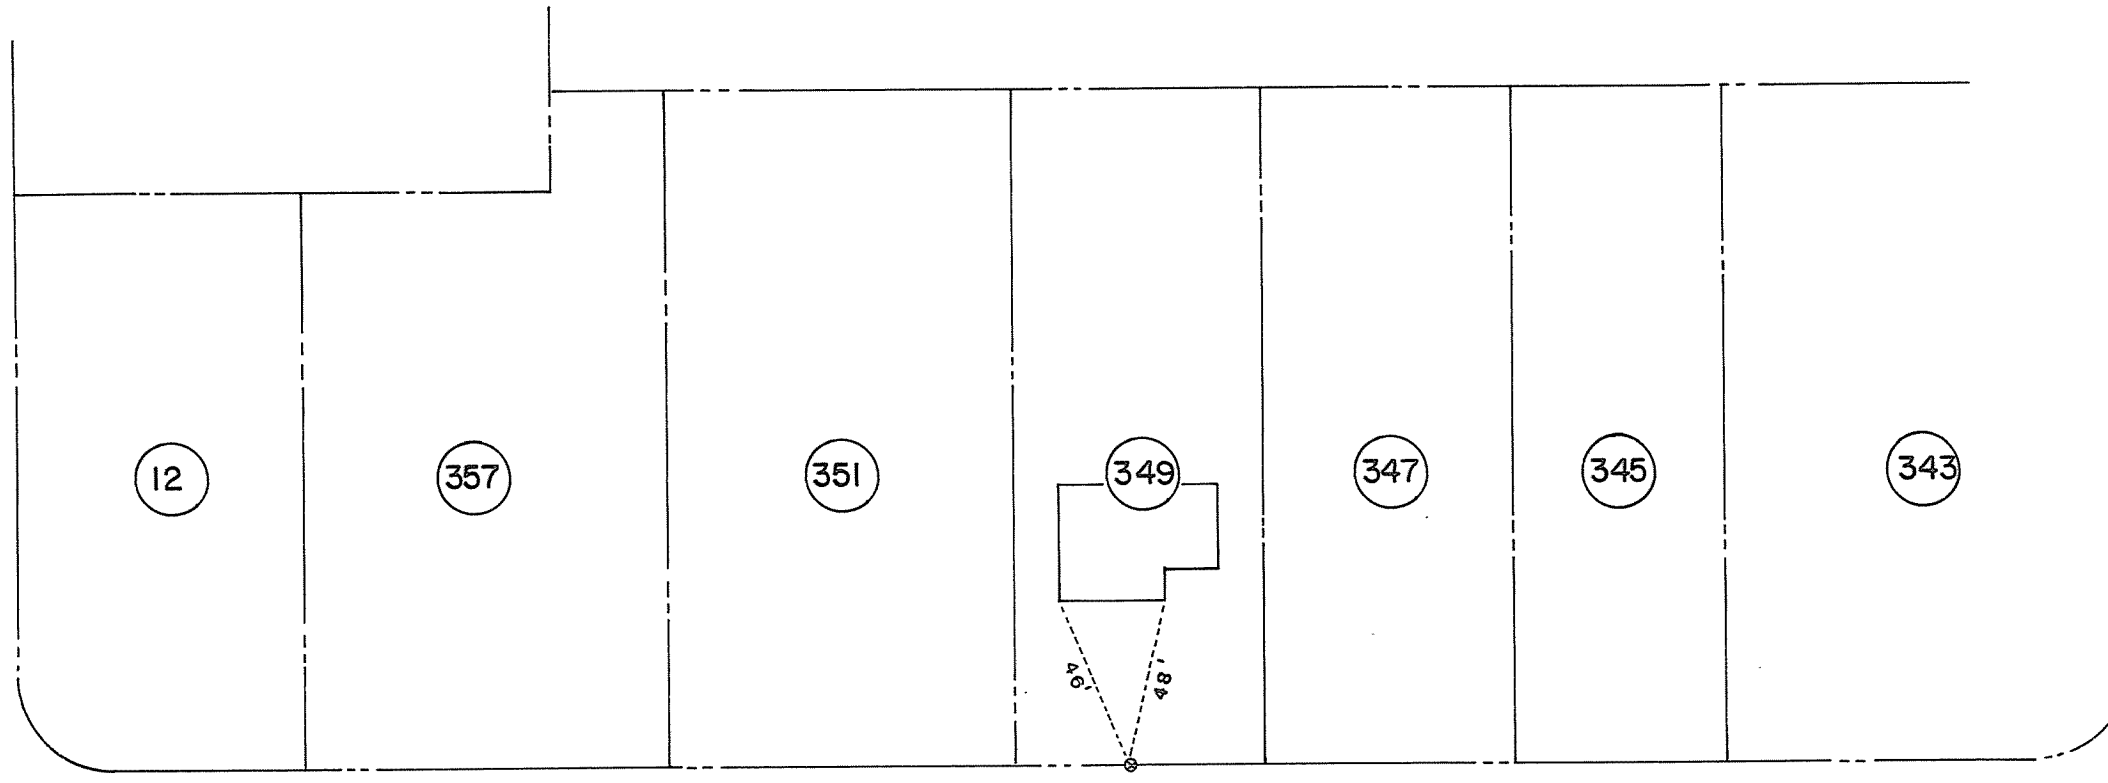


WELLINGTON ROAD

BIRCHWOOD

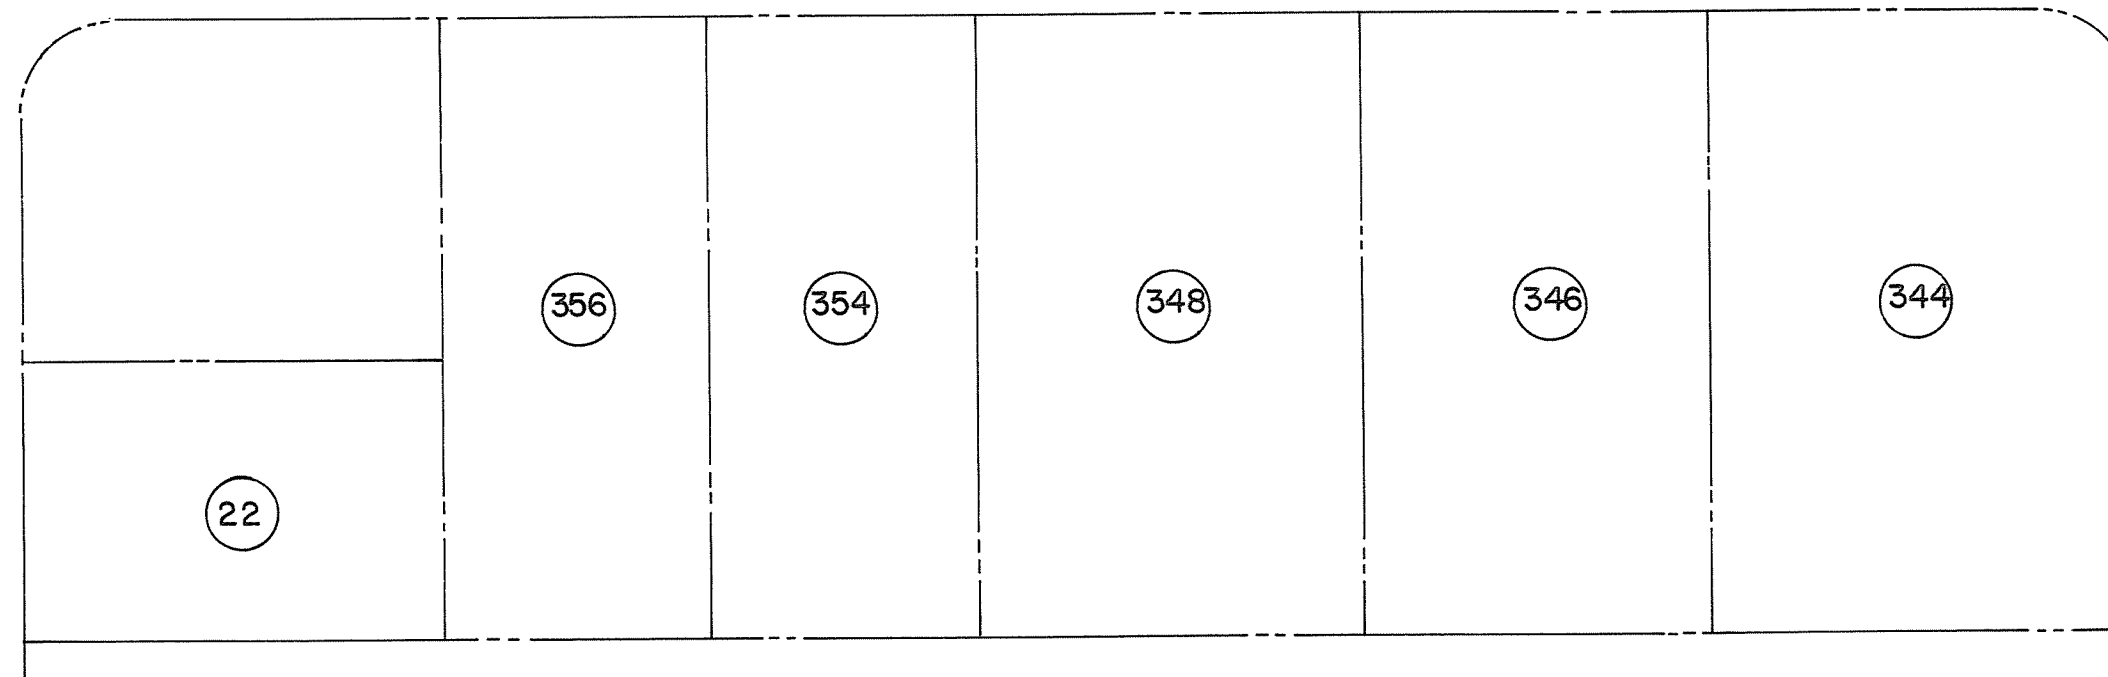

PLACE

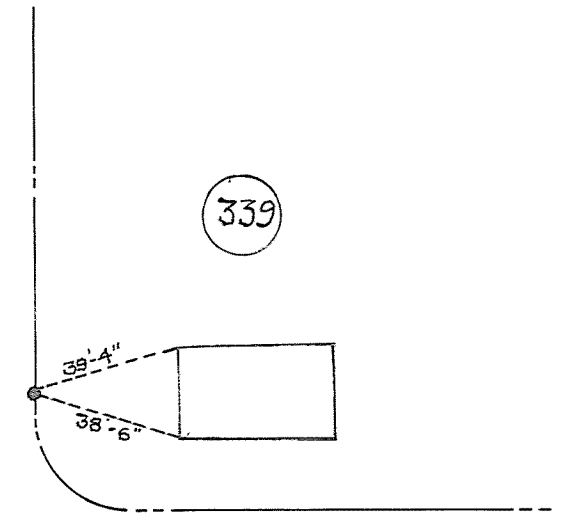

DELMAR

