



LANDS OF THE DELAWARE AND HUDSON RAILWAY COMPANY

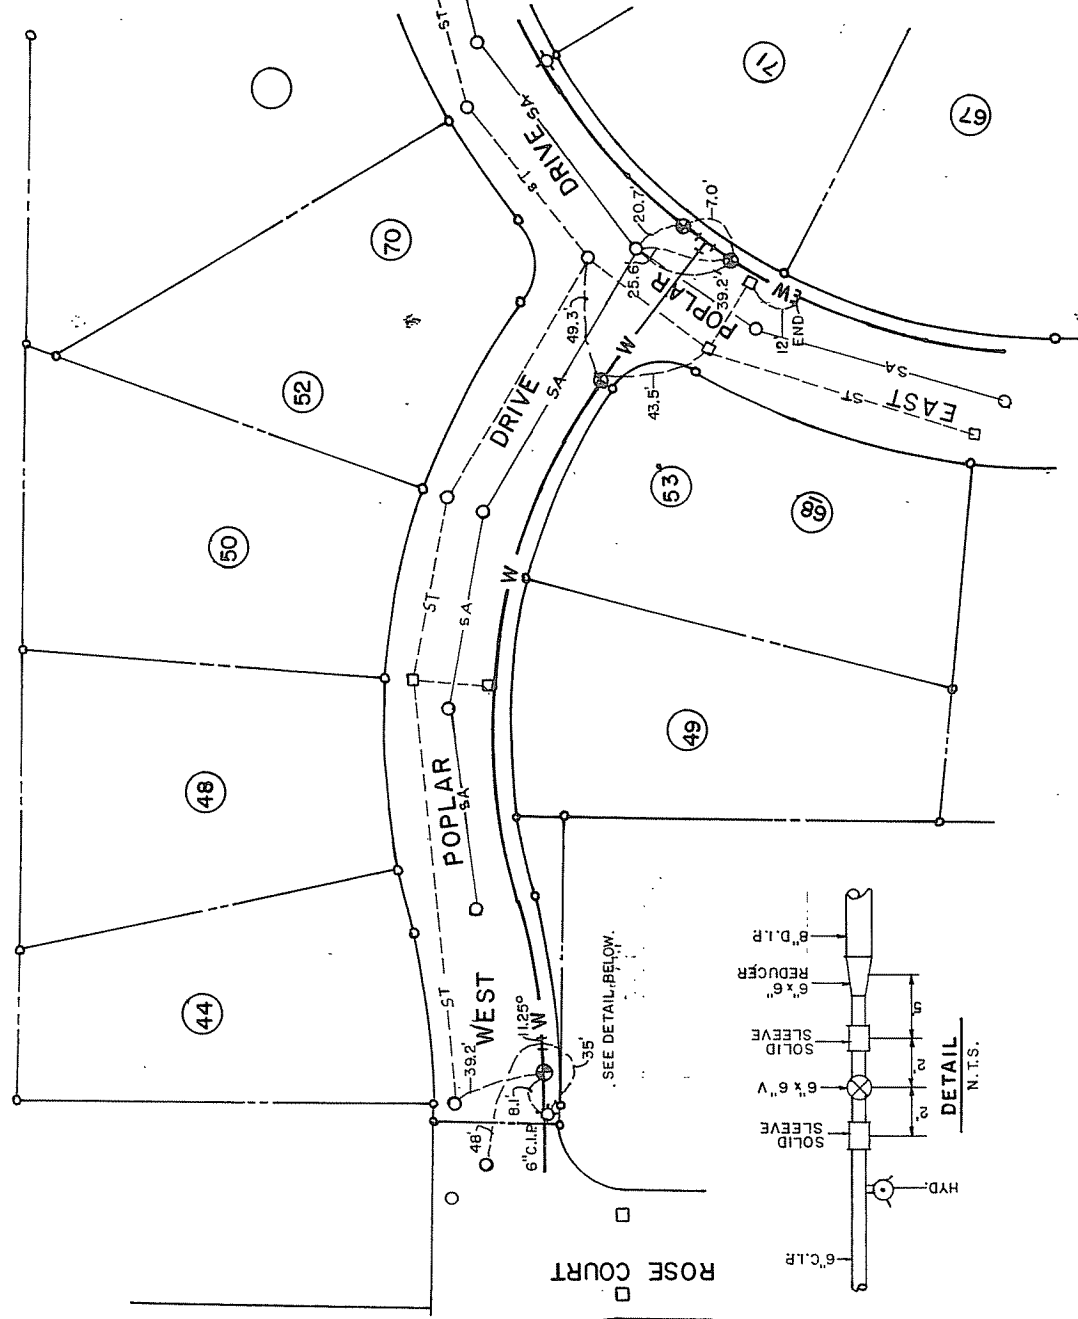

ROSE COURT

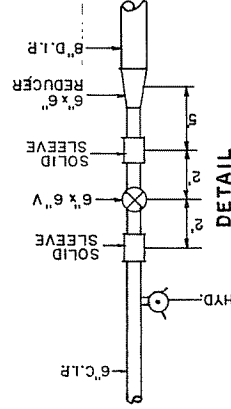

LEGEND

- CATCH BASIN
- MANHOLE
- ⊗ HYDRANT
- ⊗ GATE VALVE
- ⊥ TEE
- W — WATER MAIN

WEST POPLAR DRIVE WATER MAIN

MARCH 25, 1994

RECORD

SCALE: 1" = 50'

DRAWING

DRAWN BY M.G.

CHECKED BY T.W.R.

Revised 11/20/2014 See #1