
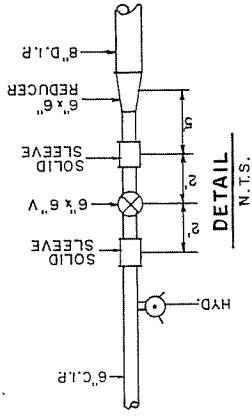


LANDS OF THE DELAWARE AND HUDSON RAILWAY COMPANY

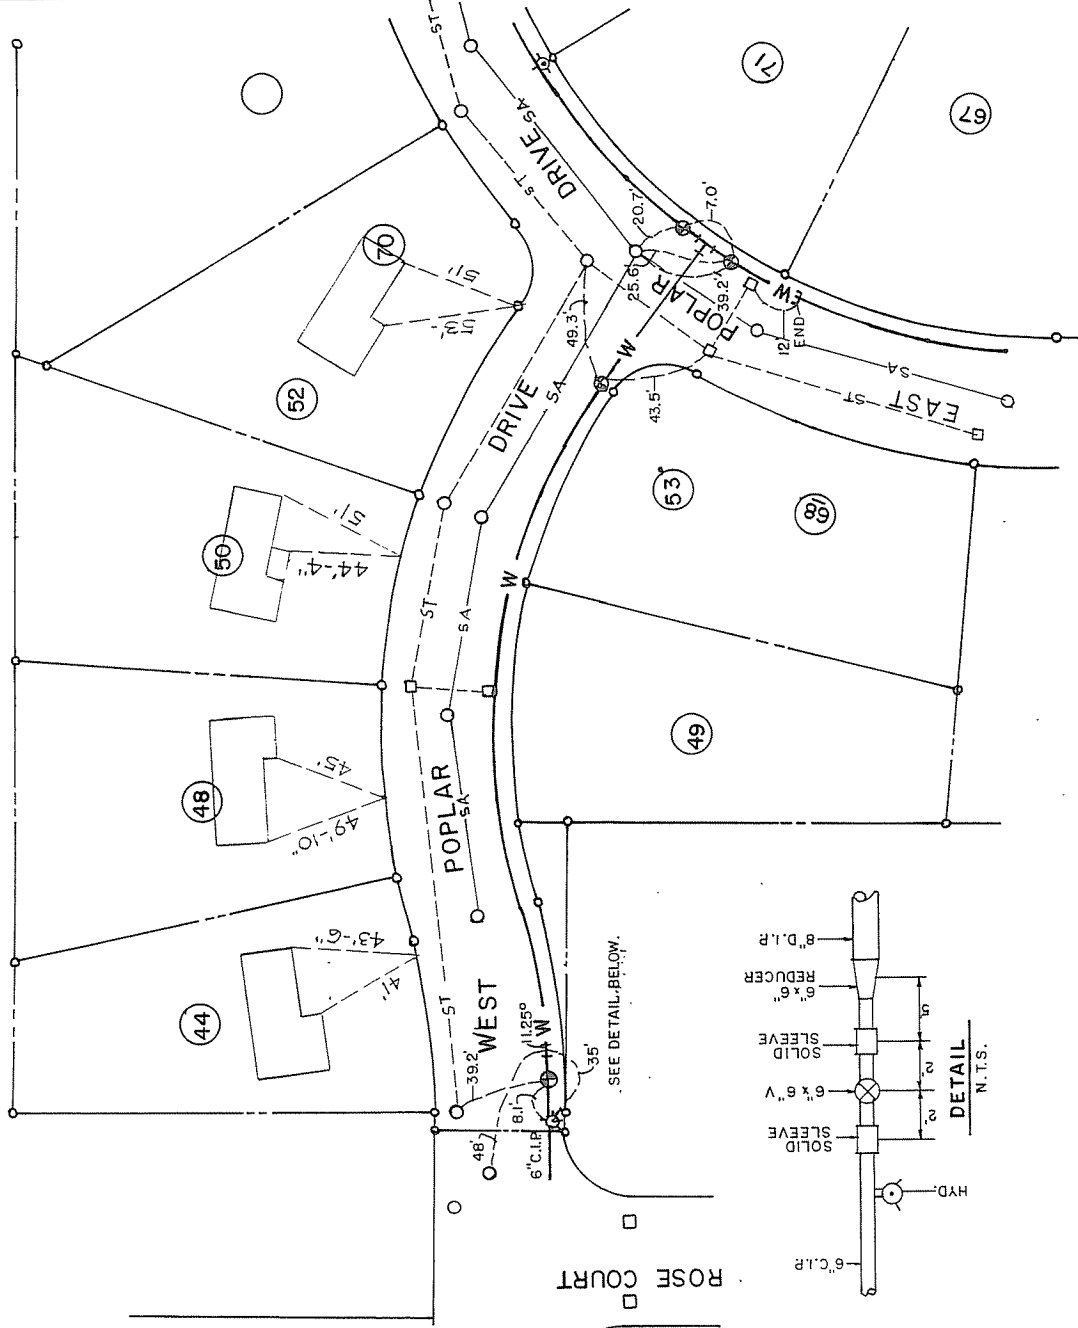

LEGEND

- CATCH BASIN
- MANHOLE
- ⊙ HYDRANT
- ⊗ GATE VALVE
- T TEE
- W WATER MAIN
- SA SANITARY SEWER
- ST STORM SEWER
- ▲ THRUST BLOCK

WEST POPLAR DRIVE
WATER MAIN

MARCH 25, 1994
SCALE: 1" = 50'
DRAWN BY M.G.
CHECKED BY T.W.R.

RECORD
DRAWING