



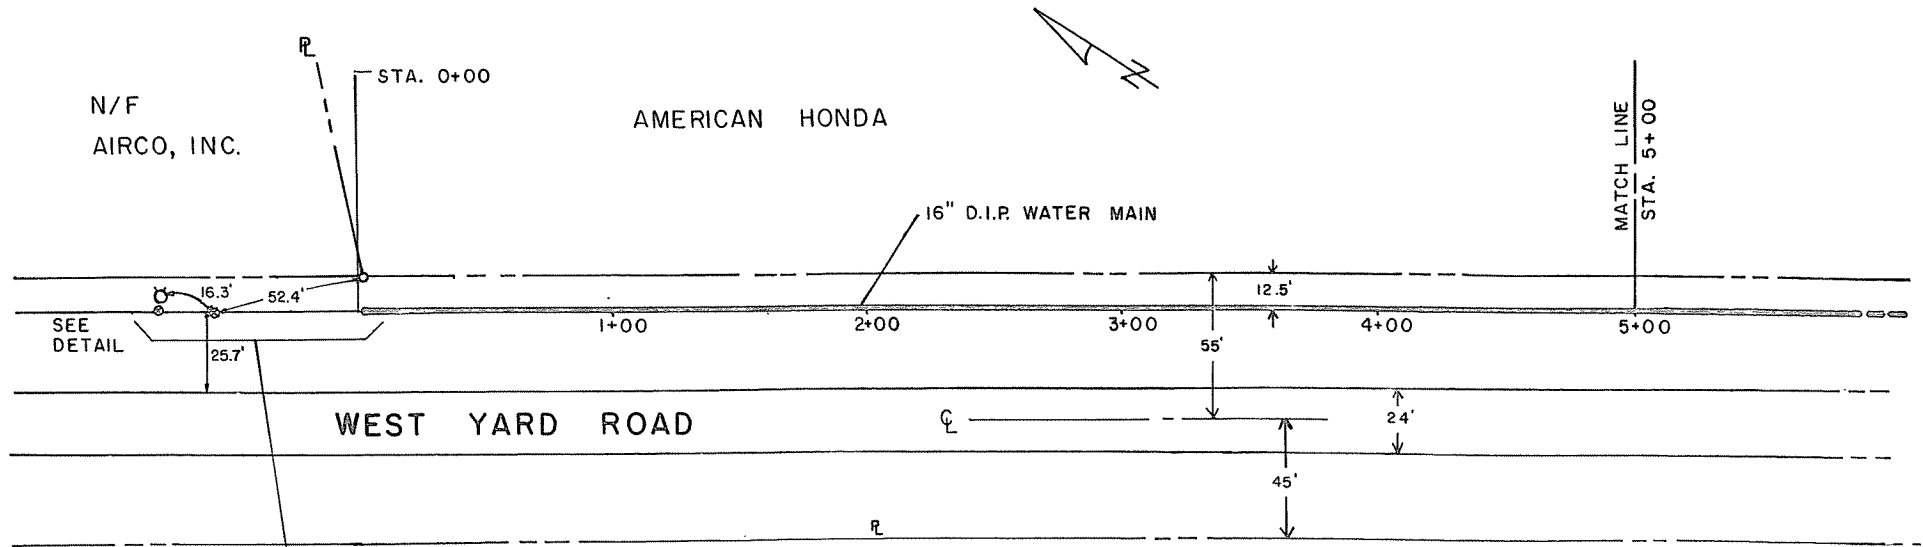

DETAIL

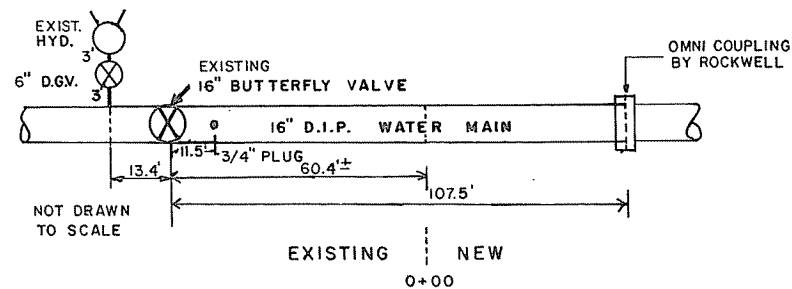

LEGEND

- CATCH BASIN
- MANHOLE
- ⊙ HYDRANT
- ⊕ GATE VALVE
- ⊥ TEE
- △ TRUSS BLOCK
- W— WATER MAIN

WEST YARD ROAD
INDUSTRIAL AREA - FEURA BUSH
EXTENSION NO. 4
WATER DISTRICT NO. 1
TOWN OF BETHLEHEM
RECORD OF INSTALLATION
SCALE 1" = 50' DEC., 1987
INSTALLED AUGUST, 1986 SHEET 1 of 4