
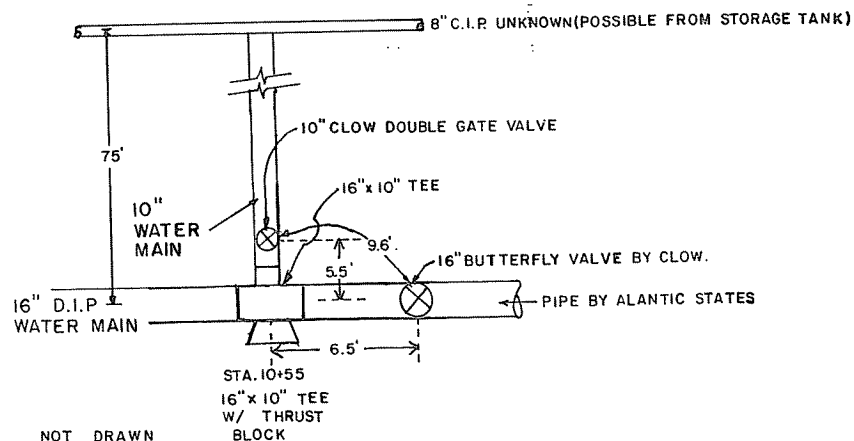


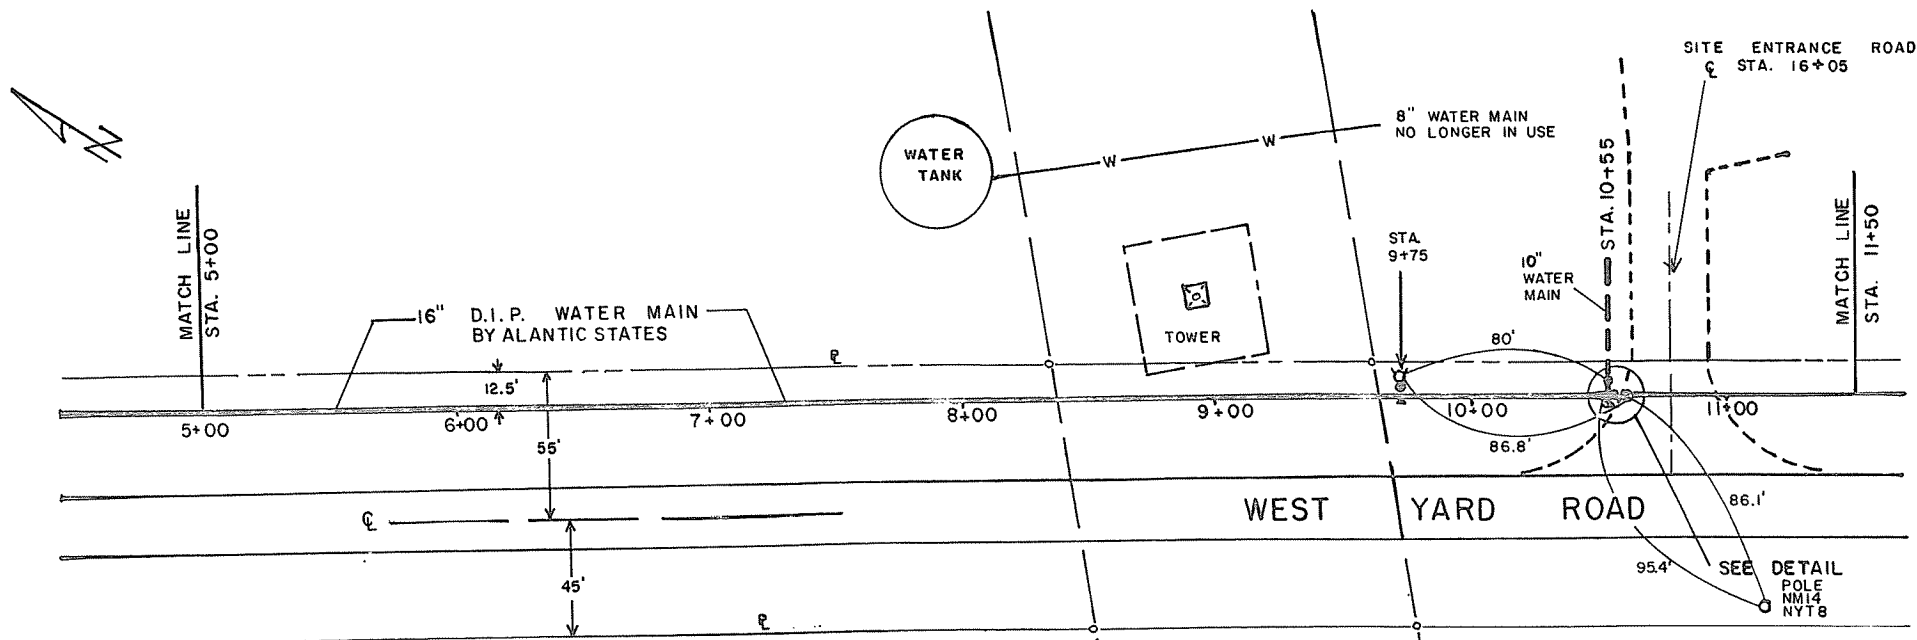

DETAIL
N.T.S.

- LEGEND**
- CATCH BASIN
 - MANHOLE
 - ⊙ HYDRANT
 - ⊕ GATE VALVE
 - ⊥ TEE
 - △ TRUSS BLOCK
 - W— WATER MAIN

WEST YARD ROAD
INDUSTRIAL AREA - FEURA BUSH
EXTENSION NO. 4
WATER DISTRICT NO. 1
TOWN OF BETHLEHEM
RECORD OF INSTALLATION
 SCALE 1" = 50' DEC., 1987
 INSTALLED AUGUST, 1986