


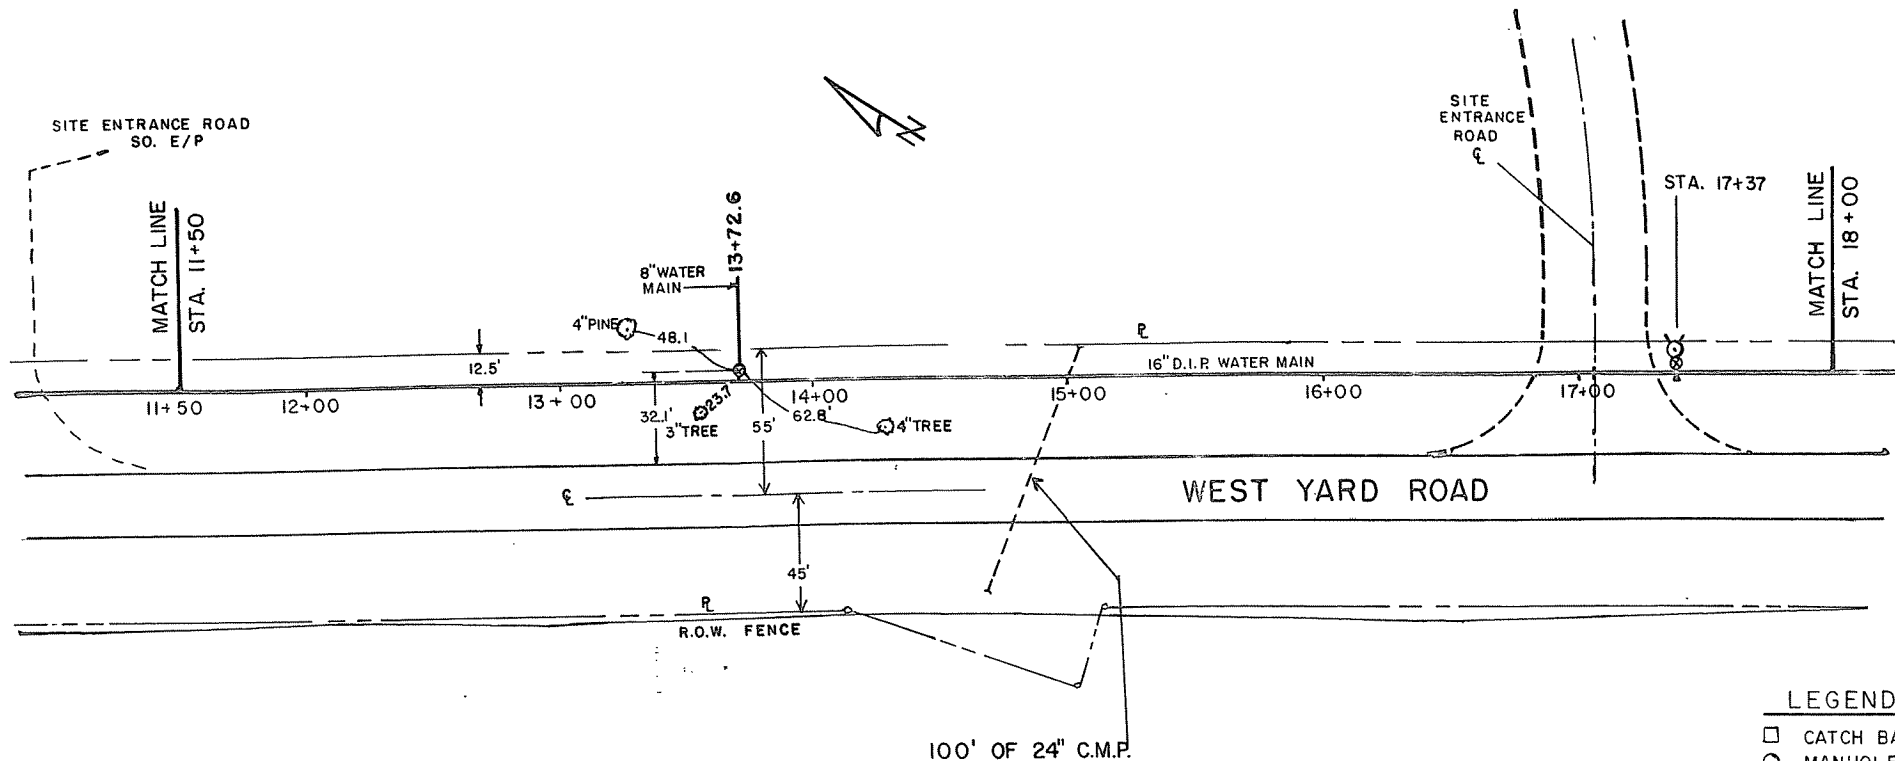

- LEGEND**
- CATCH BASIN
  - MANHOLE
  - ⊕ HYDRANT
  - ⊕ GATE VALVE
  - T TEE
  - ▲ TRUSS BLOCK
  - W— WATER MAIN

WEST YARD ROAD  
 INDUSTRIAL AREA - FEURA BUSH  
 EXTENSION NO. 4  
 WATER DISTRICT NO. 1  
 TOWN OF BETHLEHEM  
**RECORD OF INSTALLATION**  
 SCALE 1" = 50' JAN., 1988  
 INSTALLED AUGUST, 1986

DRN BY AJL  
 CHK BY CW