


DETAIL "A-A"
N. T. S.

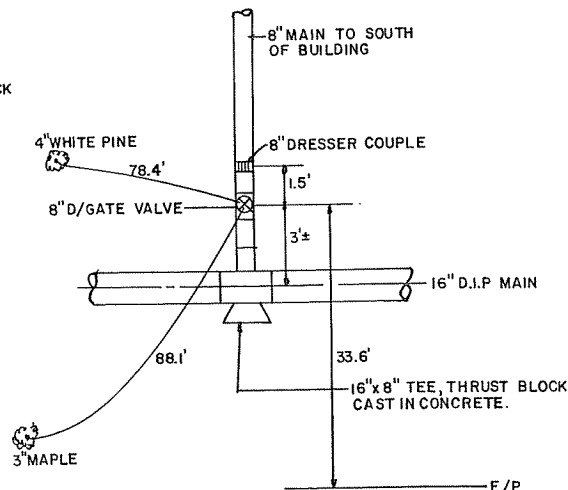

DETAIL "B-B"
N. T. S.

- LEGEND
- CATCH BASIN
 - MANHOLE
 - ⊙ HYDRANT
 - ⊕ GATE VALVE
 - T TEE
 - ▲ TRUSS BLOCK
 - W— WATER MAIN

WEST YARD ROAD
INDUSTRIAL AREA - FEURA BUSH
EXTENSION NO. 4
WATER DISTRICT NO. 1
TOWN OF BETHLEHEM
RECORD OF INSTALLATION
SCALE 1" = 50' JAN., 1988
INSTALLED AUGUST, 1986