


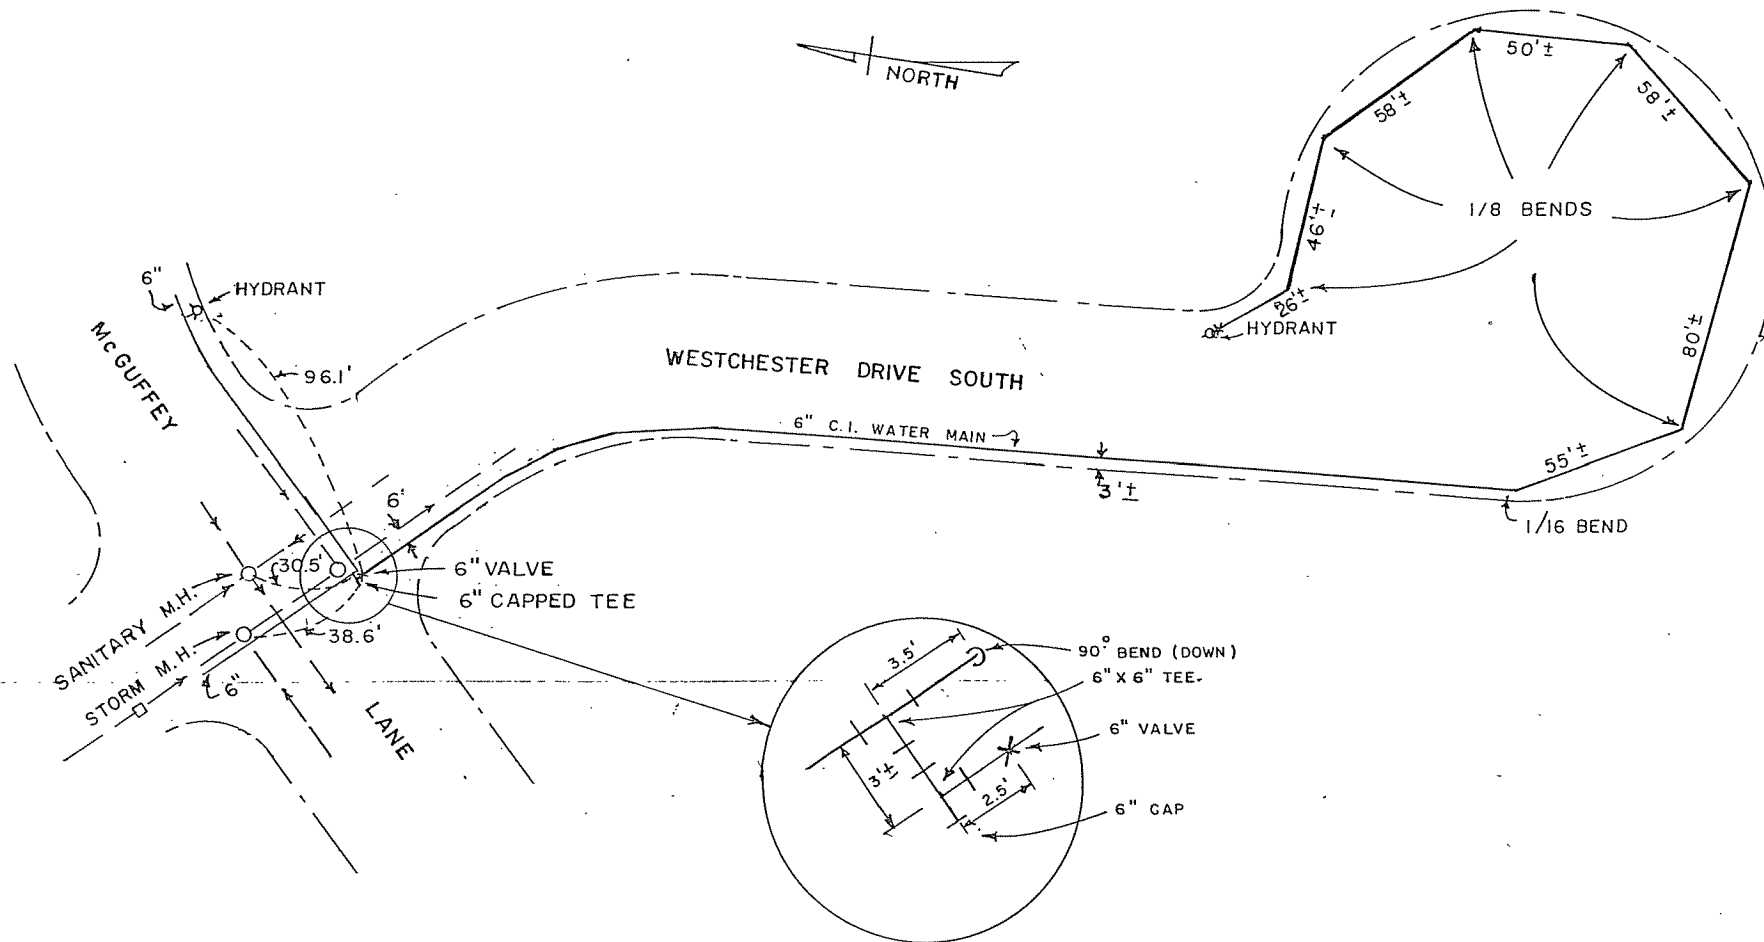

LEGEND

PROPERTY LINE ————
SEWER LINE ————
WATER LINE ————

WESTCHESTER DRIVE SOUTH
WATER DISTRICT NO. 1
TOWN OF BETHLEHEM
RECORD OF INSTALLATIONS
J. KENNETH FRASER & ASSOCIATES, P.C.
CONSULTING ENGRS. RENSSELAER, N.Y.
SCALE: 1" = 40' AUGUST 1977