


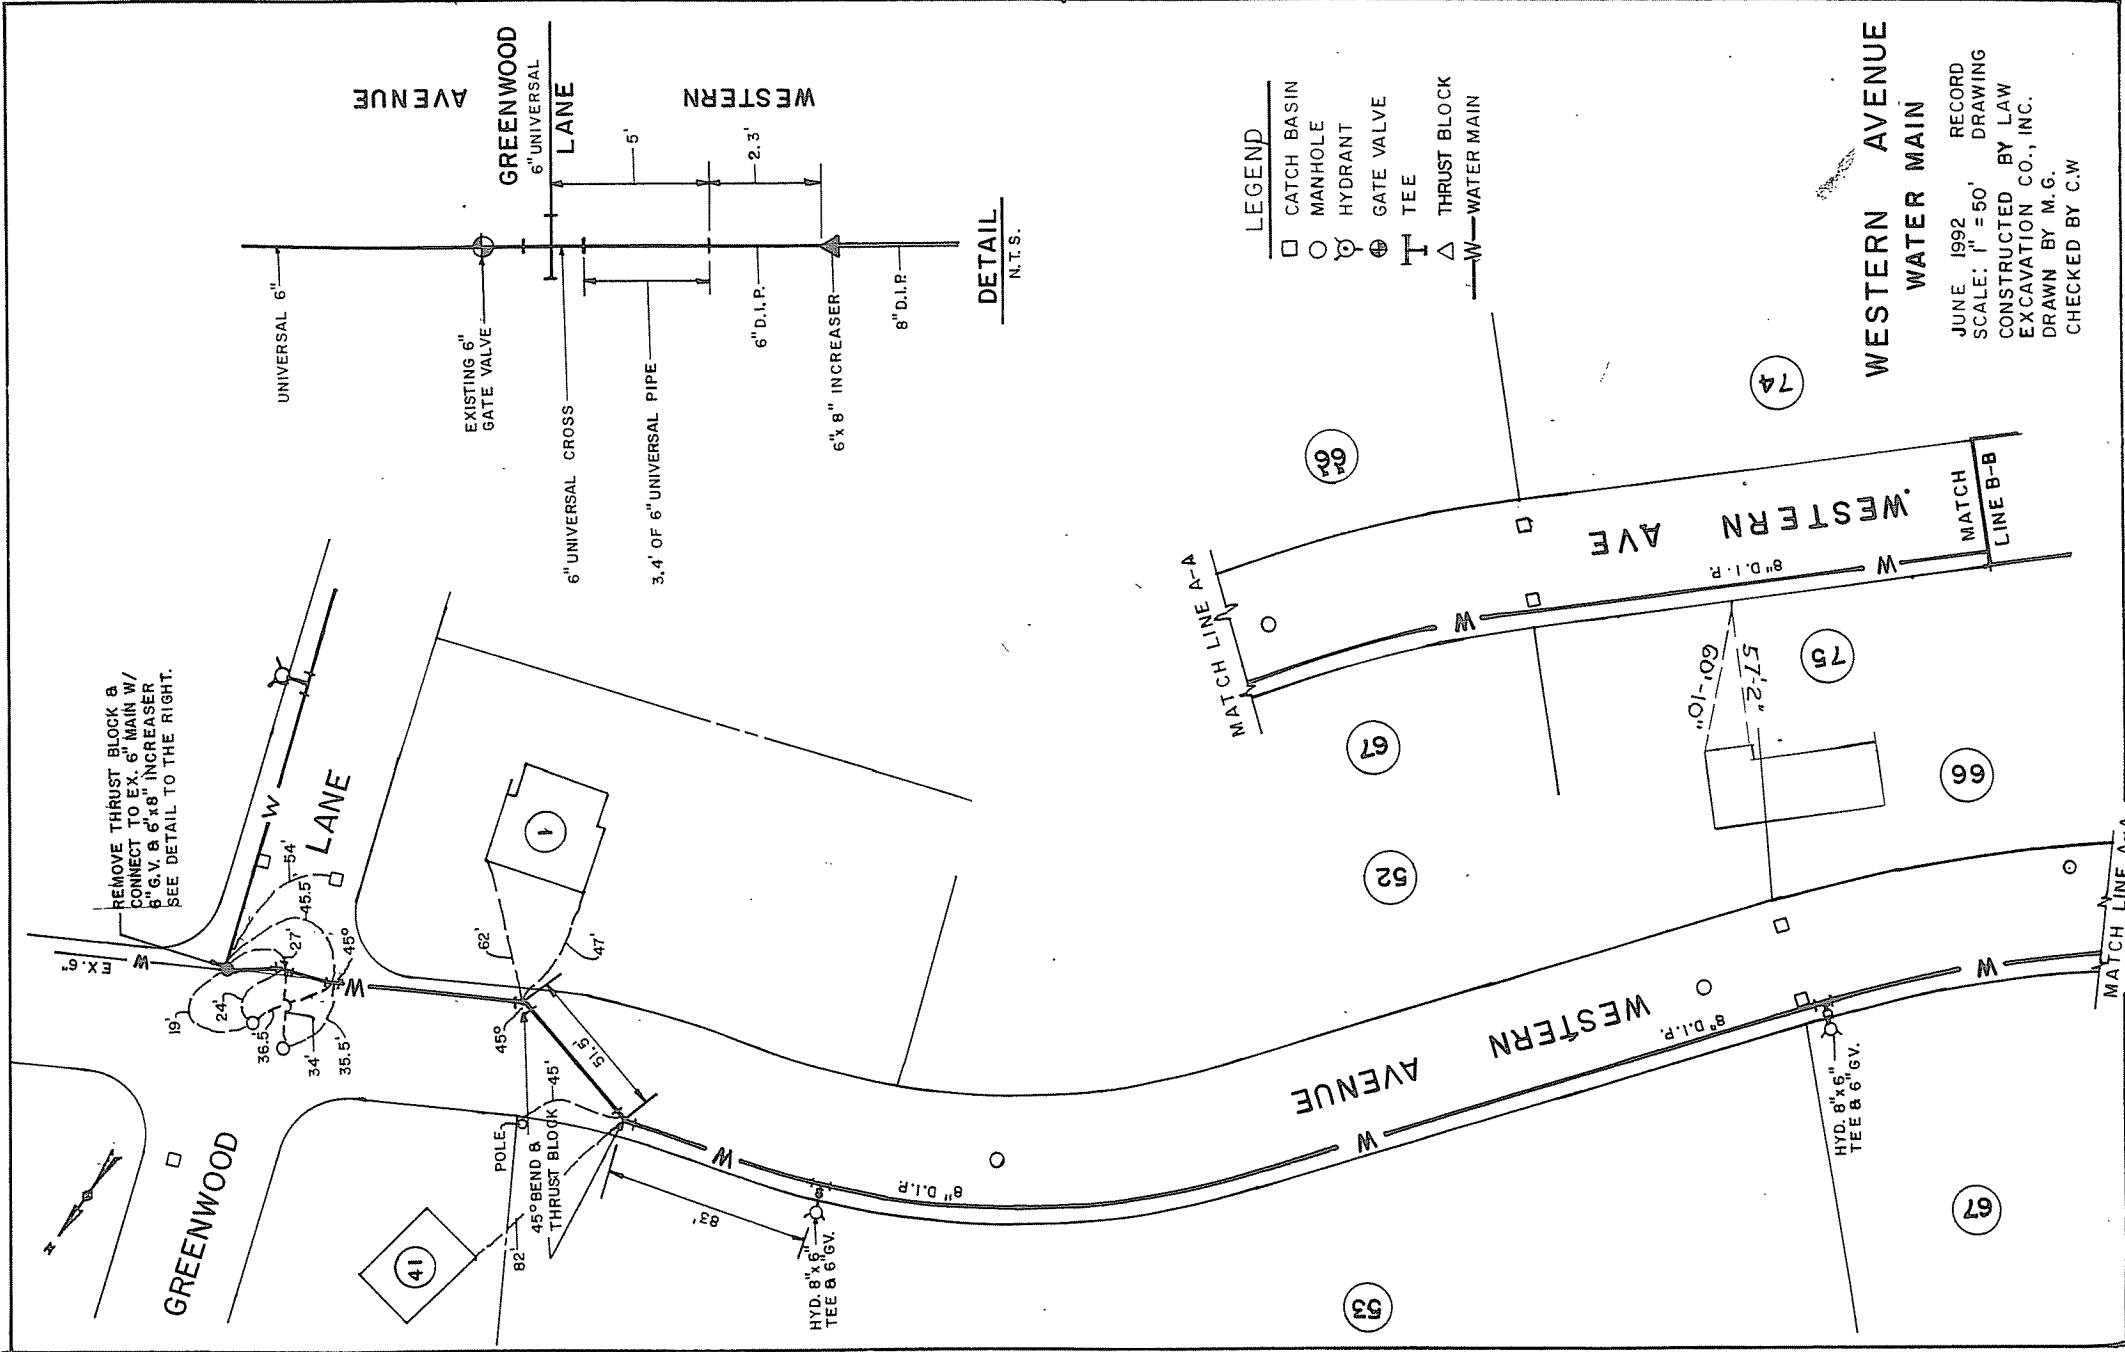

- LEGEND**
- CATCH BASIN
 - MANHOLE
 - ⊙ HYDRANT
 - ⊕ GATE VALVE
 - ⊥ TEE
 - △ THRUST BLOCK
 - W— WATER MAIN

DETAIL
N.T.S.

**WESTERN AVENUE
WATER MAIN**

JUNE 1992 RECORD
SCALE: 1" = 50'
CONSTRUCTED BY LAW
EXCAVATION CO., INC.
DRAWN BY M.G.
CHECKED BY C.W