


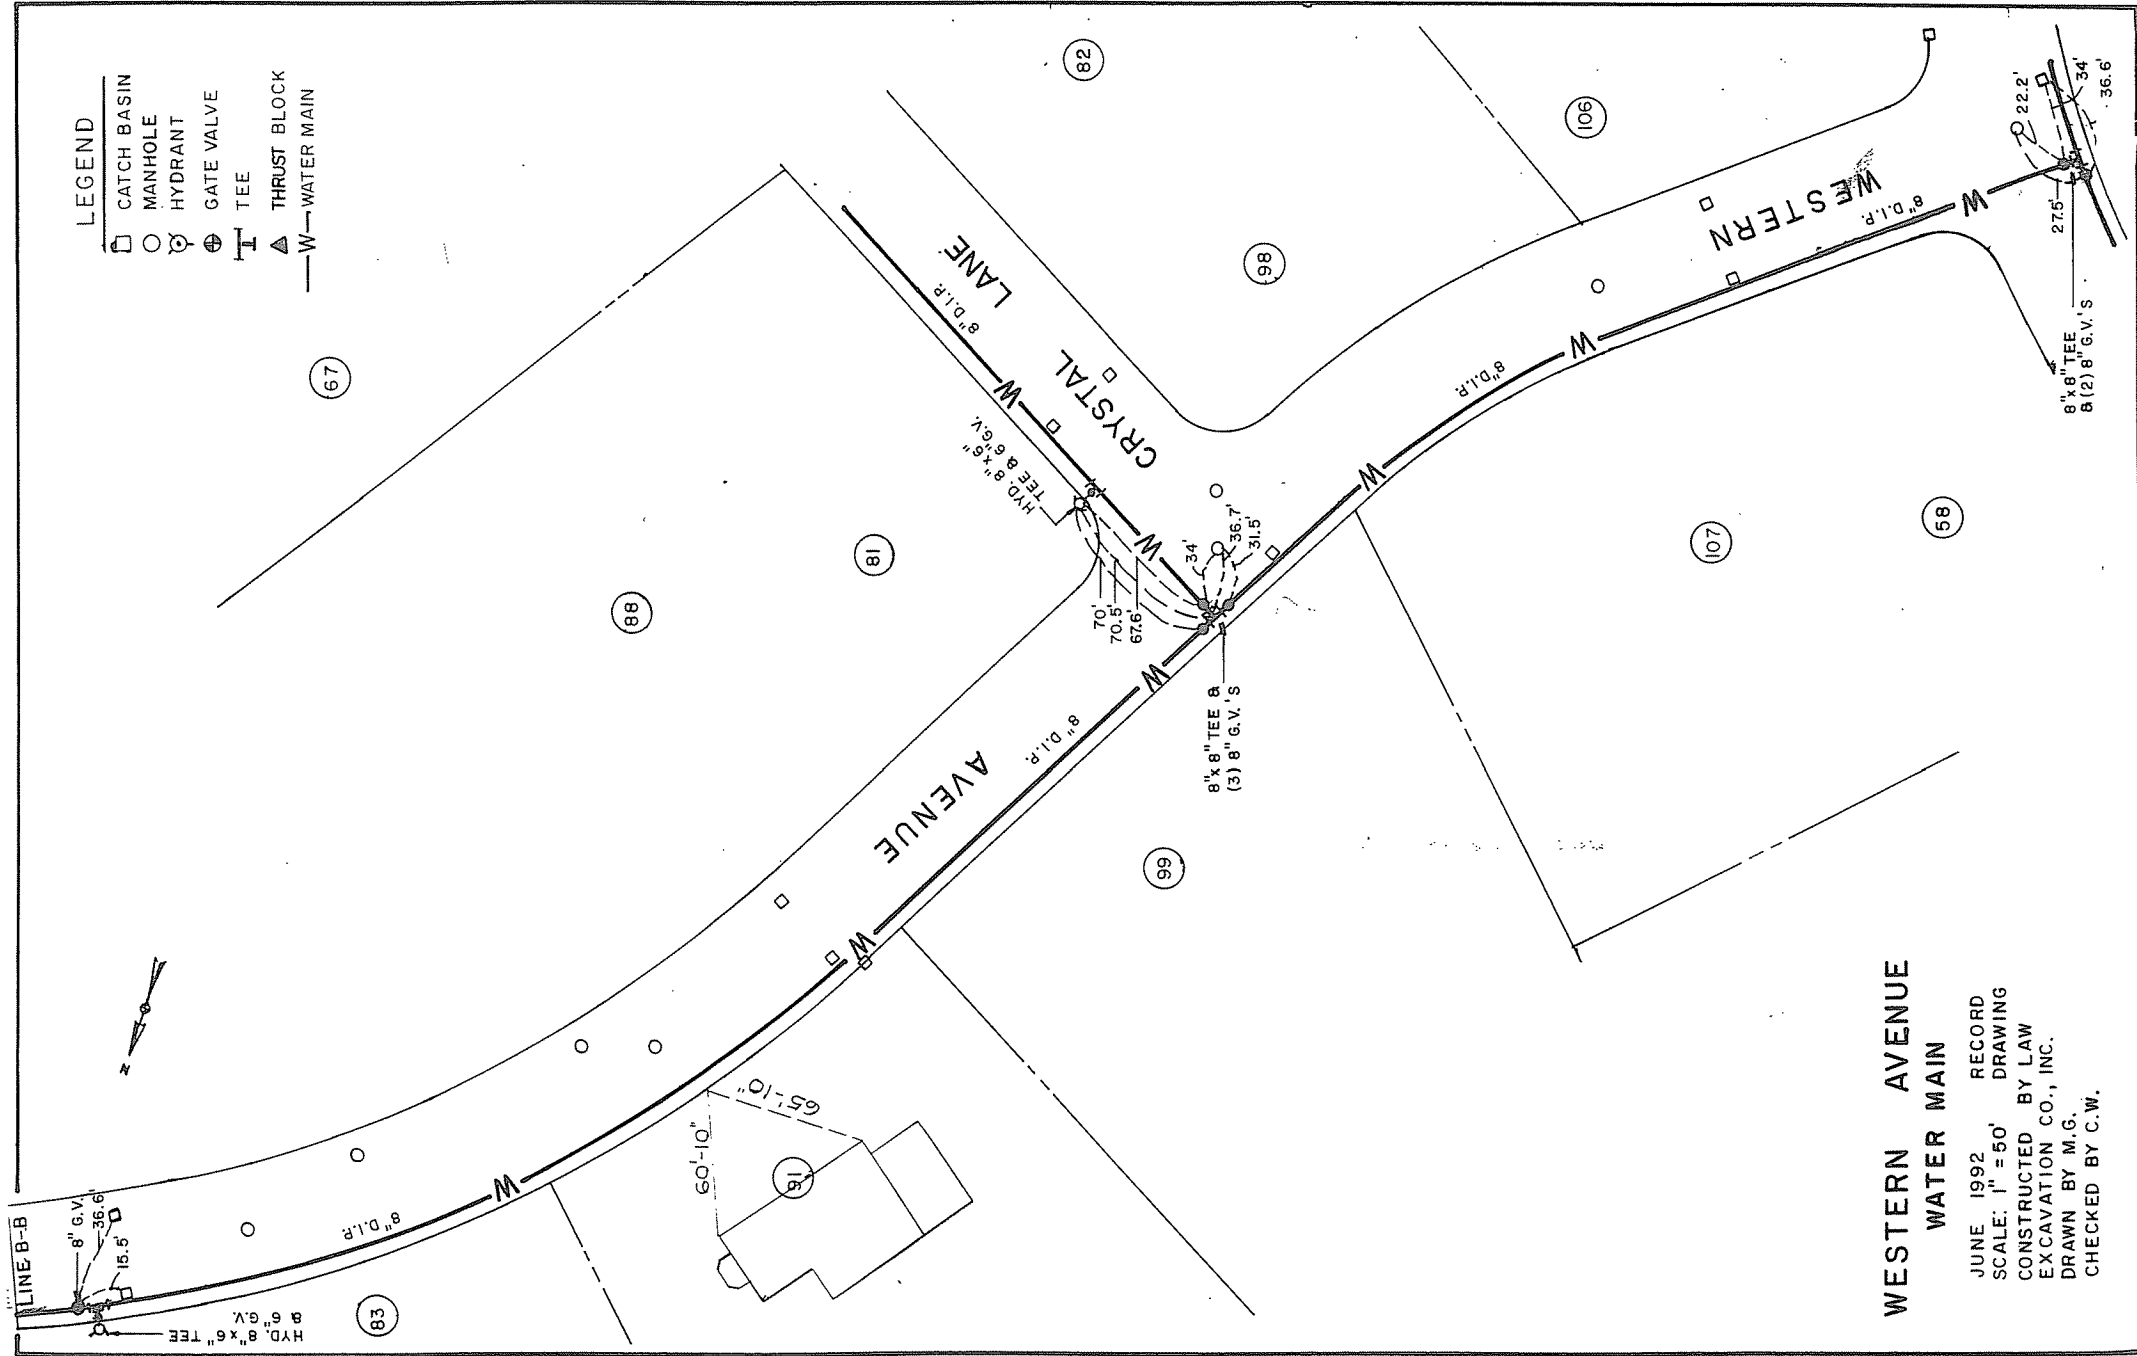

LEGEND

- CATCH BASIN
- MANHOLE
- ⊙ HYDRANT
- ⊕ GATE VALVE
- ⊥ TEE
- ▲ THRUST BLOCK
- W — WATER MAIN

WESTERN AVENUE WATER MAIN

JUNE 1992 RECORD
SCALE: 1" = 50' DRAWING
CONSTRUCTED BY LAW
EXCAVATION CO., INC.
DRAWN BY M.G.
CHECKED BY C.W.